

# **National Grid SA-CO** **PRODUCTION FILE**

**Contractor : ABB Contracting Co.**

**Project : SS 8709- 132/13.8kV in Alkha**

**Contract No : 11131113/00**

**Substation : 8709**

**Subject : 132Kv Busbar Protection Set-  
Relay Panel-4**

**ABB**




POWER SYSTEMS NETWORK MANAGEMENT  
PROTECTION AND SUBSTATION AUTOMATION SYSTEMS  
WBS NO: S-13656

ABB AUTOMATION COMPANY LTD.  
414, AL-KHARJ ROAD  
SECOND INDUSTRIAL CITY  
RIYADH-11383 K.S.A

CONTRACTOR : ABB Contracting Company  
CLIENT : National GridSA  
PROJECT : CONSTRUCTION OF NEW 132/13.8kV SS 8709 IN AL-KHARJ CITY  
SUBSTATION : S/S 8709  
CONTRACT NO. : 11131113/00  
TITLE : Assembly Drawing – +BBP1-4  
[132KV BUSBAR PROTECTION MAIN-1 BAY UNIT PANEL]

AS-BUILT BY _____ DATE _____			CONTRACT NO. 11131113/00		JOB ORDER NO. S-13656		COVER SHEET		الشركة الوطنية لنقل الكهرباء نقل الكهرباء National Grid sa					
01	13 49	FACTORY ASBUILT	DRAWN BY RIZ		CHECKED BY KVR		132KV BUSBAR PROTN.MAIN-1 BU PANEL +BBP1-4		INDEX	PLANT NO.	DRAWING NUMBER	SHEET NO.	REV. NO.	
00	13 05	FOR APPROVAL	DATE STARTED 28.01.2013		DATE COMPLETED		S/S 8709 - 132/13.8KV IN AL-KHARJ CITY		-	C421	CD-322996	SHT	CONT.	
REV. NO.	DATE	DESCRIPTION	OPRG. DEPT. CTPD		ENG. DEPT. AUT-PSAC		RIYADH SAUDI ARABIA					G00	G01	01

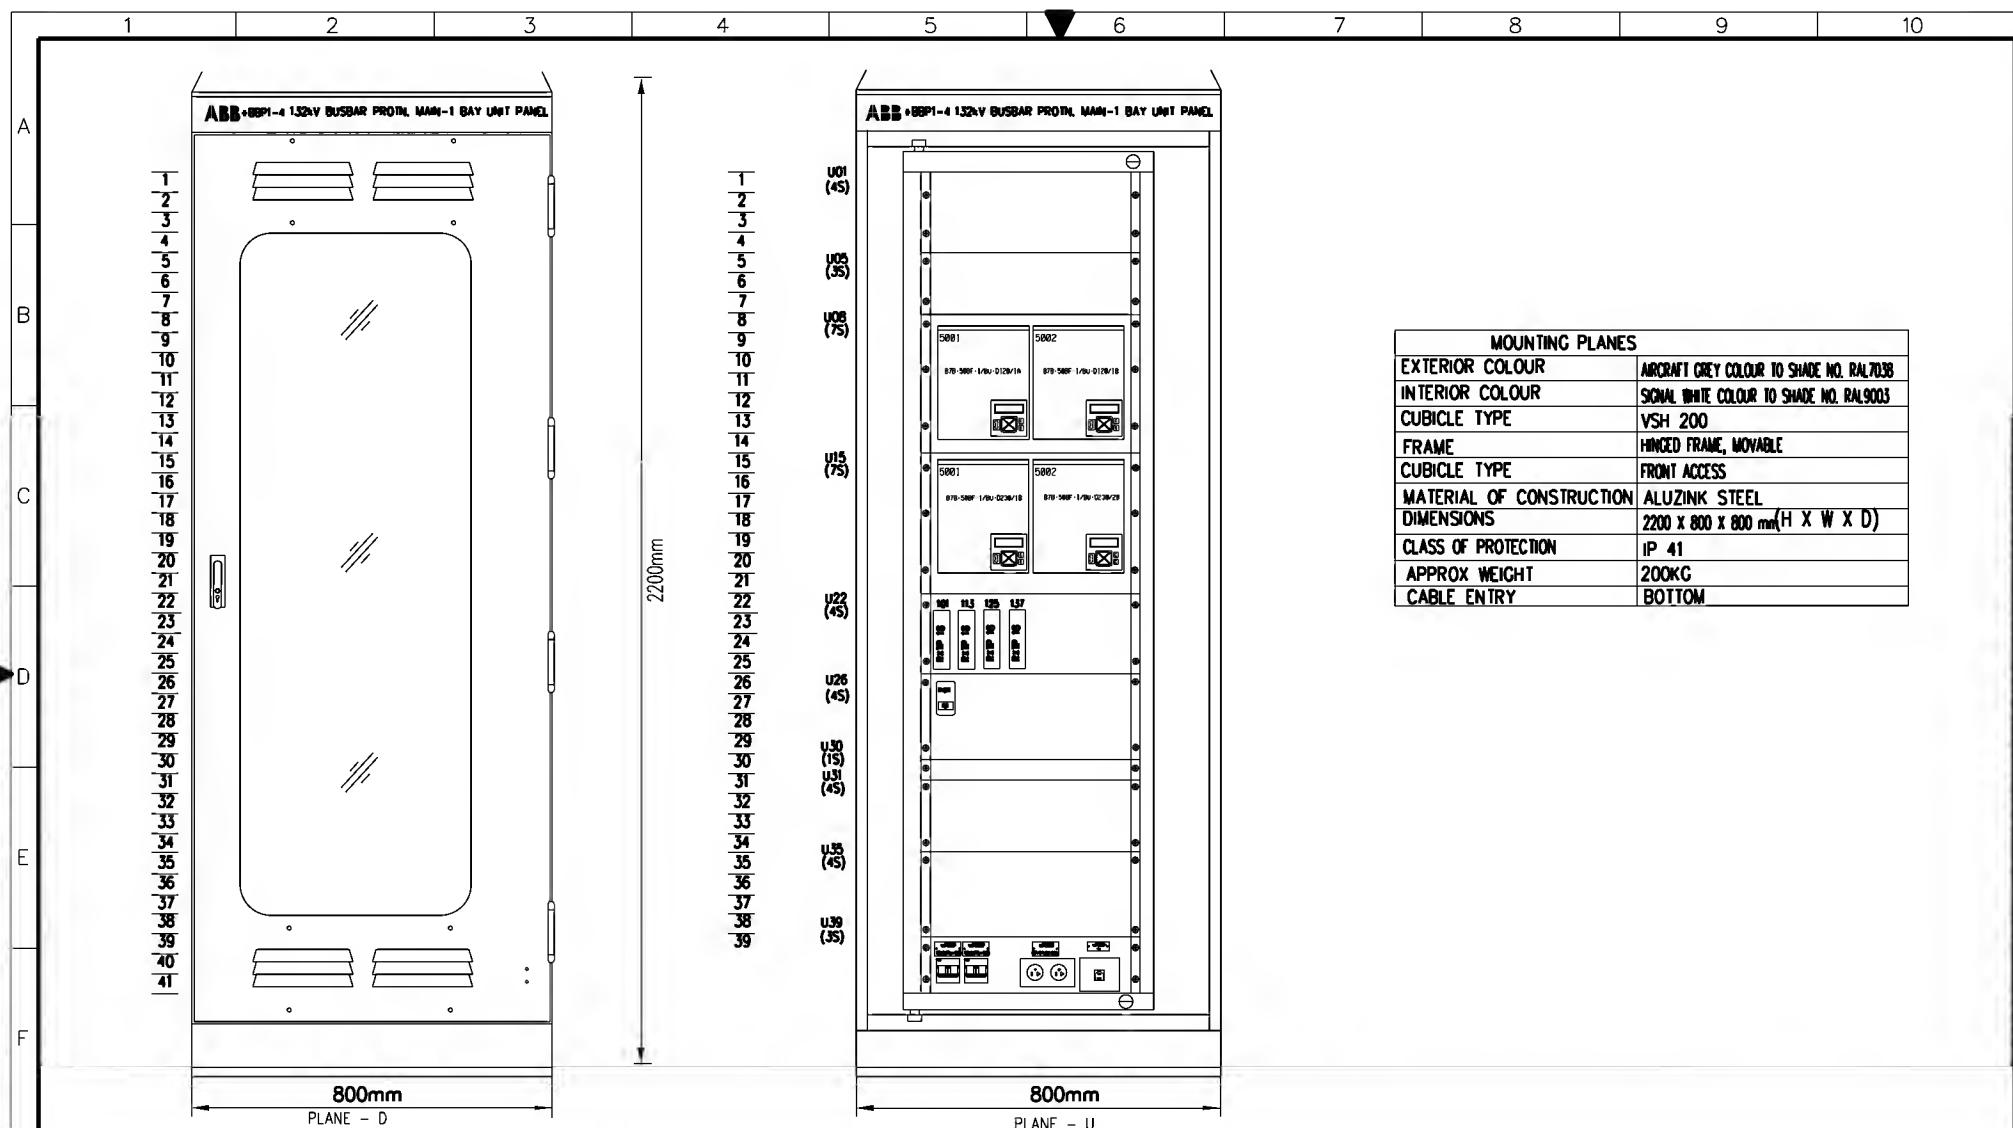

MOUNTING PLANES	
EXTERIOR COLOUR	AIRCRAFT GREY COLOUR TO SHADE NO. RAL7038
INTERIOR COLOUR	SIGNAL WHITE COLOUR TO SHADE NO. RAL9003
CUBICLE TYPE	VSH 200
FRAME	HINGED FRAME, MOVABLE
CUBICLE TYPE	FRONT ACCESS
MATERIAL OF CONSTRUCTION	ALUZINK STEEL
DIMENSIONS	2200 x 800 x 800 mm (H X W X D)
CLASS OF PROTECTION	IP 41
APPROX. WEIGHT	200KG
CABLE ENTRY	BOTTOM

AS-BUILT BY

DATE

CONTRACT NO.

11131113/00

JOB ORDER NO.

S-13656

01

13 49

FACTORY ASBUILT

00

13 05

FOR APPROVAL

REV. NO.

DATE

DESCRIPTION

DPRG. DEPT.

CTPD

ENG. DEPT.

AUT-PSAC

DRAWN BY

RIZ

CHECKED BY

KVR

DATE STARTED

28.01.2013

DATE COMPLETED

ASSEMBLY DRAWING


132KV BUSBAR PROT.N.MAIN-1 BU PANEL +BBP1-4

S/S 8709 - 132/13.8KV IN AL-KHARJ CITY

RIYADH SAUDI ARABIA

نقل الكهرباء

الشركة الوطنية لنقل الكهرباء



National Grid sa

INDEX

PLANT NO.

DRAWING NUMBER

SHEET NO.

REV. NO.

-

C421


CD-322996

SHT

G01

G02

01

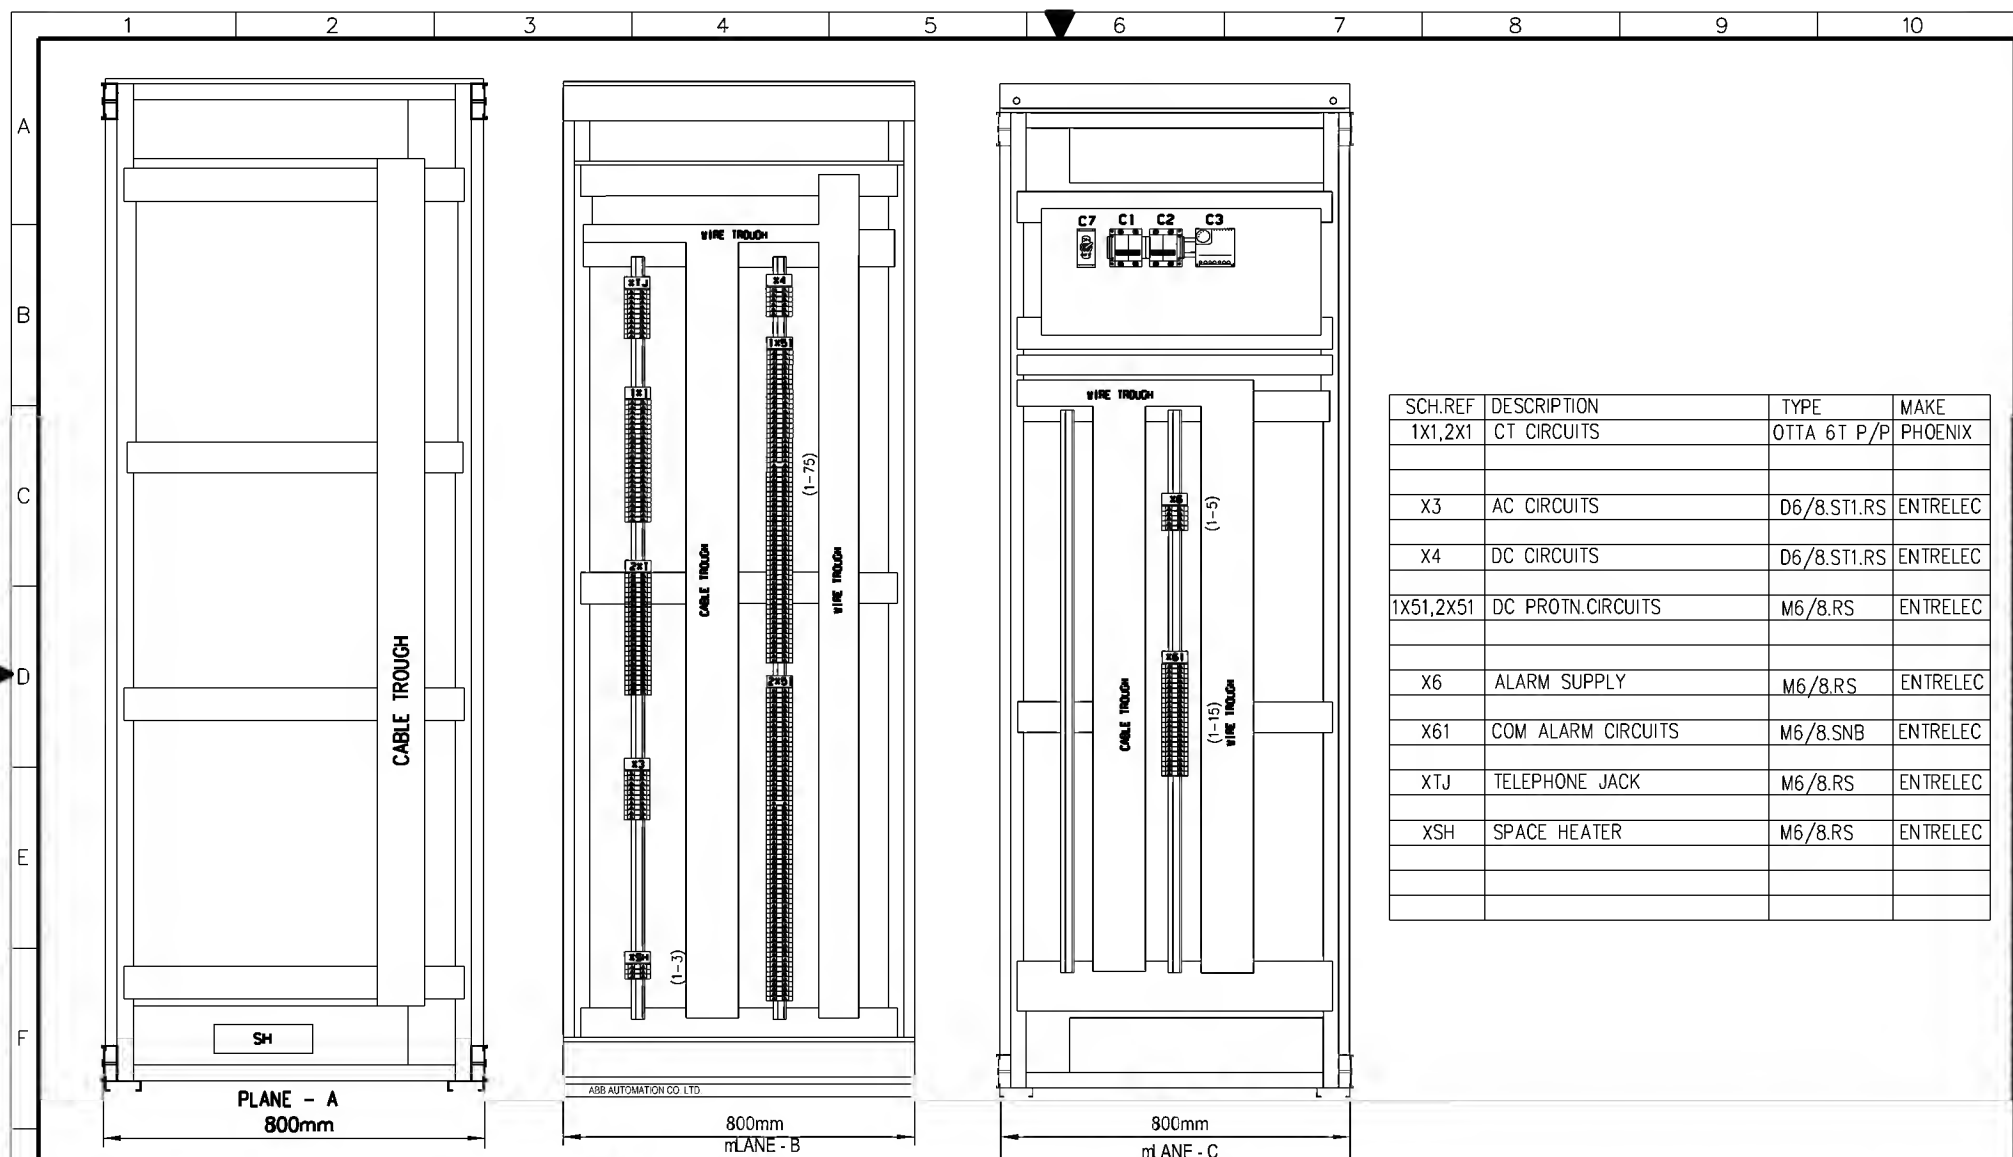

SCH.REF	DESCRIPTION	TYPE	MAKE
1X1,2X1	CT CIRCUITS	OTTA 6T P/P	PHOENIX
X3	AC CIRCUITS	D6/8.ST1.RS	ENTRELEC
X4	DC CIRCUITS	D6/8.ST1.RS	ENTRELEC
1X51,2X51	DC PROTN.CIRCUITS	M6/8.RS	ENTRELEC
X6	ALARM SUPPLY	M6/8.RS	ENTRELEC
X61	COM ALARM CIRCUITS	M6/8.SNB	ENTRELEC
XTJ	TELEPHONE JACK	M6/8.RS	ENTRELEC
XSH	SPACE HEATER	M6/8.RS	ENTRELEC

AS-BUILT BY \_\_\_\_\_ DATE \_\_\_\_\_ CONTRACT NO. **1113113/00** JOB ORDER NO. **S-13656**

**01** **13 49** **FACTORY ASBUILT**  
**00** **13 05** **FOR APPROVAL**

DRAWN BY **RIZ** CHECKED BY **KVR**  
DATE STARTED **28.01.2013** DATE COMPLETED \_\_\_\_\_  
PRG. DEPT. **CTPD** ENG. DEPT. **AUT-PSAC**

### ASSEMBLY DRAWING


**132KV BUSBAR PROTN.MAIN-1 BU PANEL +8BP1-4**  
**S/S 8709 - 132/13.8KV IN AL-KHARJ CITY**  
**RIYADH SAUDI ARABIA**

الشركة الوطنية لنقل الكهرباء




INDEX	PLANT NO.	DRAWING NUMBER	SHEET NO.	REV. NO.
-	<b>C421</b>	<b>CD-322996</b>	<b>G02 G03</b>	<b>01</b>

# BASE PLATE/ FOUNDATION

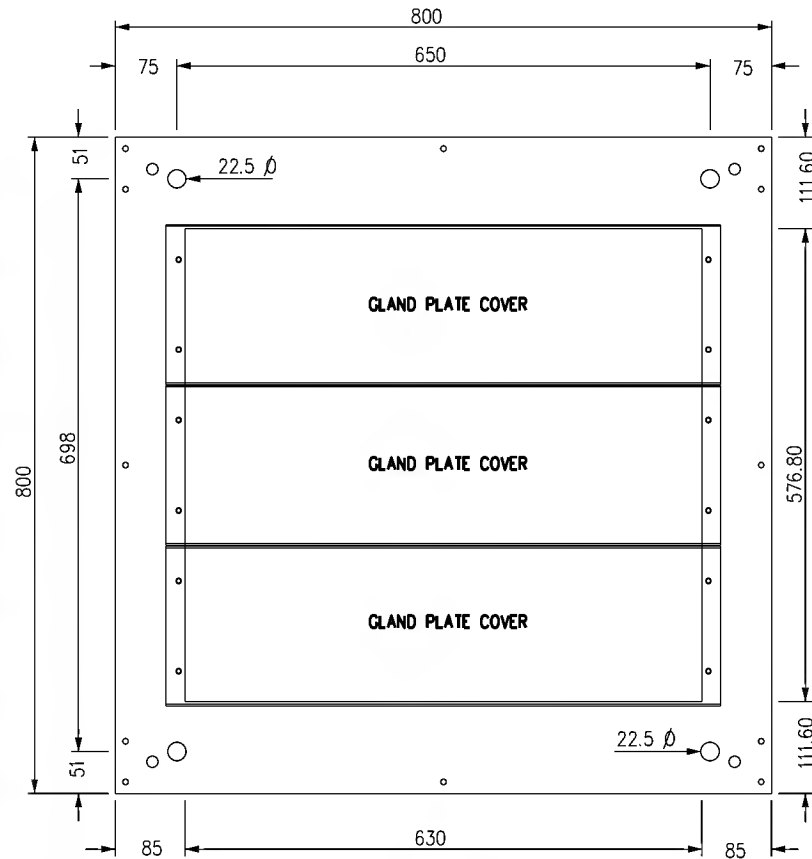

# PLAN

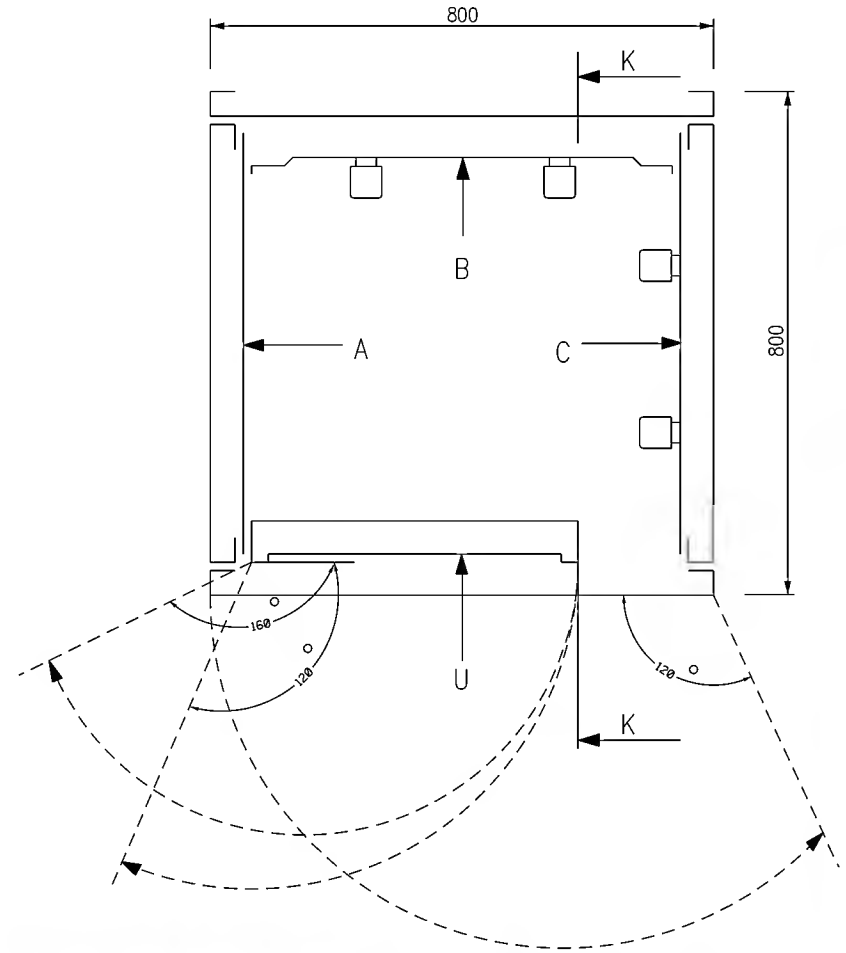

AS-BUILT BY \_\_\_\_\_ DATE \_\_\_\_\_ CONTRACT NO. **1113113/00** JOB ORDER NO. **S-13656**

01	13 49	FACTORY ASBUILT
00	13 05	FOR APPROVAL
REV. NO.	DATE	DESCRIPTION

DRAWN BY <b>RIZ</b>	CHECKED BY <b>KVR</b>
DATE STARTED <b>28.01.2013</b>	DATE COMPLETED _____
OPRG. DEPT. <b>CTPD</b>	ENG. DEPT. <b>AUT-PSAC</b>

## ASSEMBLY DRAWING

**132KV BUSBAR PROTN.MAIN-1 BU PANEL +BBP1-4**  
**S/S 8709 - 132/13.8KV IN AL-KHARJ CITY**  
**RIYADH SAUDI ARABIA**

الشركة الوطنية لنقل الكهرباء




INDEX	PLANT NO.	DRAWING NUMBER	SHEET NO.	REV. NO.
-	C421	CD-322996	003	01

NG/D2-0 (2012/01)

DMS VECTOR NGD200

THIS DRAWING AND THE INFORMATION CONTAINED HEREIN ARE THE SOLE PROPERTY OF NATIONAL GRID SA. NO REPRODUCTION OR TRANSMISSION IN ANY FORM OR BY ANY MEANS, WITHOUT THE WRITTEN CONSENT OF NATIONAL GRID SA, IS PERMITTED.

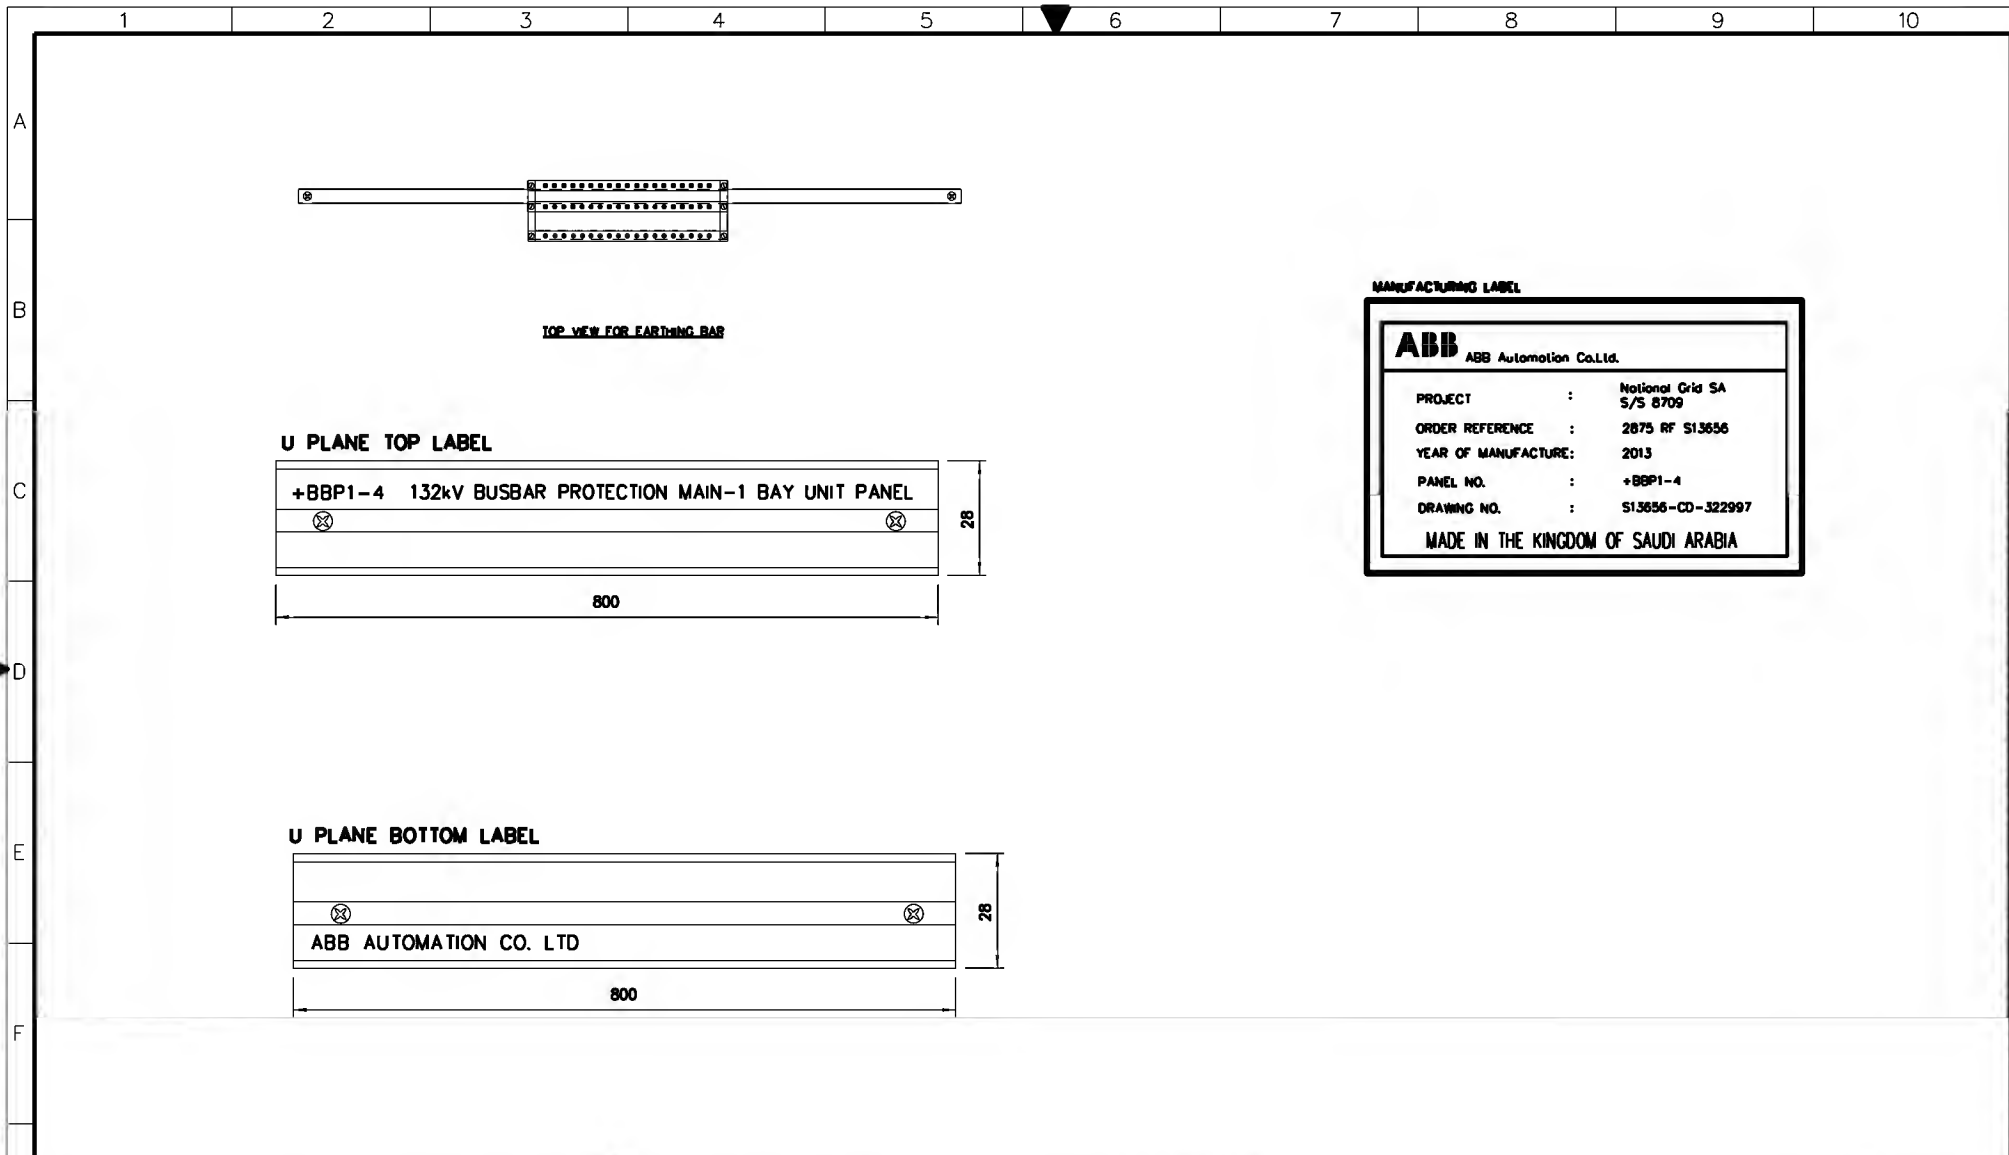

AS-BUILT BY _____ DATE _____			CONTRACT NO. 11131113/00		JOB ORDER NO. S-13656		ASSEMBLY DRAWING		الشركة الوطنية لنقل الكهرباء		نقل الكهرباء	
01 13 49			DRAWN BY RIZ		CHECKED BY KVR		132KV BUSBAR PROTN.MAIN-1 BU PANEL +BBP1-4		National Grid sa			
00 13 05			DATE STARTED 28.01.2013		DATE COMPLETED _____		S/S 8709 - 132/13.8KV IN AL-KHARJ CITY		INDEX		PLANT NO.	
REV. NO.			DESCRIPTION		PRG. DEPT. CTPD		ENG. DEPT. AUT-PSAC		DRAWING NUMBER		SHEET NO.	
			FOR APPROVAL				RIYADH SAUDI ARABIA		- C421		CD-322996	
									SHT CONT.		REV. NO.	
									G04 L00		01	



POWER SYSTEMS NETWORK MANAGEMENT  
PROTECTION AND SUBSTATION AUTOMATION SYSTEMS  
WBS NO: S-13656


ABB AUTOMATION COMPANY LTD  
414, AL-KHARJ ROAD  
SECOND INDUSTRIAL CITY  
RIYADH-11383 K.S.A

CONTRACTOR : ABB Contracting Company  
CLIENT : National Gridsa  
PROJECT : CONSTRUCTION OF NEW 132/13.8kV SS 8709 IN AL-KHARJ CITY  
SUBSTATION : S/S 8709  
CONTRACT NO. : 11131113/00  
TITLE : LIST OF APPARATUS - +BBP1-4  
[132KV BUSBAR PROTECTION MAIN-1 BAY UNIT PANEL]

AS-BUILT BY _____ DATE _____		CONTRACT NO. 11131113/00	JOB ORDER NO. S-13656	COVER SHEET		الشركة الوطنية لنقل الكهرباء		نقل الكهرباء	
DRAWN BY RIZ CHECKED BY KVR		132KV BUSBAR PROT.N.MAIN-1 BU PANEL +BBP1-4		INDEX		PLANT NO.	DRAWING NUMBER	SHEET NO.	REV. NO.
DATE STARTED 28.01.2013 DATE COMPLETED _____		S/S 8709 - 132/13.8KV IN AL-KHARJ CITY		- C421			CD-322996	SHT CONT.	
OPRG. DEPT. CTPD ENG. DEPT. AUT-PSAC		RIYADH SAUDI ARABIA						L00L01	01
REV. NO.	DATE	DESCRIPTION							
01	13 49	FACTORY ASBUILT							
00	13 05	FOR APPROVAL							

1	2	3	4	5	6	7	8	9	10
---	---	---	---	---	---	---	---	---	----

[illegible]


AS-BUILT BY _____ DATE _____			CONTRACT NO. <b>1113113/00</b>		JOB ORDER NO. <b>S-13656</b>		<b>LIST OF APPARATUS</b> <b>132KV BUSBAR PROT.N.MAIN-1 BU PANEL +BBP-4</b> <b>S/S 8709 - 132/13.8KV IN AL-KHARJ CITY</b> <b>RIYADH SAUDI ARABIA</b>				<b>نقل الكهرباء</b> <b>الشركة الوطنية لنقل الكهرباء</b>  <b>National Grid sa</b>				
<b>01 13 49 FACTORY ASBUILT</b> <b>00 13 05 FOR APPROVAL</b>			DRAWN BY <b>RIZ</b> CHECKED BY <b>KVR</b> DATE STARTED <b>28.01.2013</b> DATE COMPLETED _____						INDEX PLANT NO. DRAWING NUMBER SHEET NO. REV. NO. - C421 CD-322996 01 02 01						
REV. NO. DATE DESCRIPTION			UPRG. DEPT. <b>CTPD</b> ENG. DEPT. <b>AUT-PSAC</b>												





	2	3	4	5		6	7	8	9	10
--	---	---	---	---	---	---	---	---	---	----

[illegible]

AS-BUILT BY _____ DATE _____			CONTRACT NO. <b>11131113/00</b>		JOB ORDER NO. <b>S-13656</b>		<b>LIST OF APPARATUS</b> <b>132KV BUSBAR PROT.N.MAIN-1 BU PANEL +B8P1-4</b> <b>S/S 8709 - 132/13.8KV IN AL-KHARJ CITY</b> <b>RIYADH SAUDI ARABIA</b>			<b>نقل الكهرباء</b> <b>الشركة الوطنية لنقل الكهرباء</b>  <b>National Grid SA</b>				
<b>01 13 49</b> <b>00 13 05</b> <b>FACTORY ASBUILT</b> <b>FOR APPROVAL</b>			DRAWN BY <b>RIZ</b> CHECKED BY <b>KVR</b> DATE STARTED <b>28.01.2013</b> DATE COMPLETED _____ OPRG. DEPT. <b>CTPD</b> ENG. DEPT. <b>AUT-PSAC</b>					INDEX PLANT NO. DRAWING NUMBER SHEET NO. REV. NO. <b>- C421 CD-322996 103104 01</b>						



LABEL REF.	LABEL ENGRAVING	MATERIALS	ENGRAVING	LABEL SIZE	LETTER SIZE
U08.5001	U08.5001 878+508F-1/BU-D120/1A	TRAFOLITE	BLACK LETTERS ON WHITE BACKGROUND	50X15mm	4mm
U08.5002	U08.5002 878+508F-1/BU-D120/1B	TRAFOLITE	BLACK LETTERS ON WHITE BACKGROUND	50X15mm	4mm
U15.5001	U15.5001 878+508F-1/BU-D230/1B	TRAFOLITE	BLACK LETTERS ON WHITE BACKGROUND	50X15mm	4mm
U15.5002	U15.5001 878+508F-1/BU-D230/2B	TRAFOLITE	BLACK LETTERS ON WHITE BACKGROUND	50X15mm	4mm
U22.5001	U22.5001 IS-1	ALUMINUM PAPER FOL	BLACK LETTERS	50X10mm	3mm
U22.5002	U22.5002 IS-2	ALUMINUM PAPER FOL	BLACK LETTERS	50X10mm	3mm
U22.5003	U22.5003 IS-3	ALUMINUM PAPER FOL	BLACK LETTERS	50X10mm	3mm
U22.5004	U22.5004 IS-4	ALUMINUM PAPER FOL	BLACK LETTERS	50X10mm	3mm
U26.101	U26.101 748F-1/D120 748F-1/D230	ALUMINUM PAPER FOL	BLACK LETTERS	50X10mm	3mm
U37.5001	U37.5001 DC SUPPLY MCB FOR D120	TRAFOLITE	BLACK LETTERS ON WHITE BACKGROUND	50X15mm	4mm
U37.5002	U37.5002 DC SUPPLY MCB FOR D230	TRAFOLITE	BLACK LETTERS ON WHITE BACKGROUND	50X15mm	4mm
U37.5003	U37.5003 C01-127V,C02-220V	TRAFOLITE	BLACK LETTERS ON WHITE BACKGROUND	50X15mm	4mm
U37.5004	U37.5004 UJ	TRAFOLITE	BLACK LETTERS ON WHITE BACKGROUND	50X15mm	4mm

AS-BUILT BY _____ DATE _____		CONTRACT NO. <b>11131113/00</b>	JOB ORDER NO. <b>S-13656</b>	<b>LIST OF APPARATUS</b>		نقل الكهرباء الشركة الوطنية لنقل الكهرباء National Grid sa	
<b>01</b>	<b>13 49</b>	<b>FACTORY ASBUILT</b>		DRAWN BY <b>RIZ</b>	CHECKED BY <b>KVR</b>	<b>132KV BUSBAR PROTN,MAIN-1 BU PANEL +8BP1-4</b> <b>S/S 8709 - 132/13.8KV IN AL-KHARJ CITY</b> <b>RIYADH SAUDI ARABIA</b>	
<b>00</b>	<b>13 05</b>	<b>FOR APPROVAL</b>		DATE STARTED <b>28.01.2013</b> DATE COMPLETED _____		INDEX	PLANT NO.
REV. NO.	DATE	DESCRIPTION		OPRG. DEPT. <b>CTPD</b>	ENG. DEPT. <b>AUT-PSAC</b>	DRAWING NUMBER	SHEET NO.
						<b>C421</b>	<b>CD-322996</b>
							SHEET NO. <b>L05</b> CONT. <b>L06</b> REV. NO. <b>01</b>

	1	2	3	4	5	6	7	8	9	10
A										
B										
C										
D										
E										
F										
G										

LABEL REF.	LABEL ENGRAVING	MATERIALS	ENGRAVING	LABEL SIZE	LETTER SIZE
C1	C1 127V AC SUPPLY MCB	TRAFOLITE	BLACK LETTERS ON WHITE BACKGROUND	50X15mm	4mm
C2	C2 220V AC SUPPLY MCB	TRAFOLITE	BLACK LETTERS ON WHITE BACKGROUND	50X15mm	4mm
C3	C3 THERMOSTAT	TRAFOLITE	BLACK LETTERS ON WHITE BACKGROUND	50X15mm	4mm
C7	C7 ON/OFF SWITCH	TRAFOLITE	BLACK LETTERS ON WHITE BACKGROUND	50X15mm	4mm
DS	DS DOOR SWITCH	TRAFOLITE	BLACK LETTERS ON WHITE BACKGROUND	50X15mm	4mm
IL	IL ILLUMINATION LAMP	TRAFOLITE	BLACK LETTERS ON WHITE BACKGROUND	50X15mm	4mm
SH	SH SPACE HEATER	TRAFOLITE	BLACK LETTERS ON WHITE BACKGROUND	50X15mm	4mm

AS-BUILT BY _____ DATE _____		CONTRACT NO. <b>11131113/00</b>	JOB ORDER NO. <b>S-13656</b>	<b>LIST OF APPARATUS</b>		نقل الكهرباء الشركة الوطنية لنقل الكهرباء National Grid sa	
<b>01</b>	<b>13 49</b>	<b>FACTORY ASBUILT</b>		DRAWN BY <b>RIZ</b> CHECKED BY <b>KVR</b>		132KV BUSBAR PROTN.MAIN-1 BU PANEL +8BP1-4	
<b>00</b>	<b>13 05</b>	<b>FOR APPROVAL</b>		DATE STARTED <b>28.01.2013</b> DATE COMPLETED _____		S/S 8709 - 132/13.8KV IN AL-KHARJ CITY	
REV. NO.	DATE	DESCRIPTION		OPRG. DEPT. <b>CTPD</b>	ENG. DEPT. <b>AUT-PSAC</b>	INDEX	PLANT NO.
						-	C421
							CD-322996
							SHEET NO. <b>L06000</b> CONT. <b>01</b>
							REV. NO.

THIS DRAWING AND THE INFORMATION CONTAINED HEREIN ARE THE SOLE PROPERTY OF NATIONAL GRID SA. NO REPRODUCTION OR TRANSMISSION IN ANY FORM OR BY ANY MEANS, WITHOUT THE WRITTEN CONSENT OF ITS OWNER.



POWER SYSTEMS NETWORK MANAGEMENT  
PROTECTION AND SUBSTATION AUTOMATION SYSTEMS  
WBS NO: S-13656

ABB AUTOMATION COMPANY LTD.  
414, AL-KHARJ ROAD  
SECOND INDUSTRIAL CITY  
RIYADH-11383 K.S.A

CONTRACTOR : ABB Contracting Company  
CLIENT : National Gridsa  
PROJECT : CONSTRUCTION OF NEW 132/13.8kv SS 8709 IN AL-KHARJ CITY  
SUBSTATION : S/S 8709  
CONTRACT NO. : 11131113/00  
TITLE : SCHEMATICS DRAWINGS - +BBP1-4  
[132KV BUSBAR PROTECTION MAIN-1 BAY UNIT PANEL]

AS-BUILT BY _____ DATE _____		CONTRACT NO. 11131113/00	JOB ORDER NO. S-13656	COVER SHEET		الشركة الوطنية لنقل الكهرباء National Grid sa				
01	13 49	FACTORY ASBUILT	DRAWN BY RIZ	CHECKED BY KVR	132KV BUSBAR PROTN.MAIN-1 BU PANEL +BBP1-4	INDEX	PLANT NO.	DRAWING NUMBER	SHEET NO.	REV. NO.
00	13 05	FOR APPROVAL	DATE STARTED 28.01.2013	DATE COMPLETED	S/S 8709 - 132/13.8KV IN AL-KHARJ CITY	-	C421	CD-322997	SHT CONT.	01
REV. NO.	DATE	DESCRIPTION	OPRG. DEPT. CTPD	ENG. DEPT. AUT-PSAC	RIYADH SAUDI ARABIA				000 001	



1	2	3	4	5	6	7	8	9	10																																																																																																																			
A																																																																																																																												
B																																																																																																																												
C																																																																																																																												
D																																																																																																																												
E																																																																																																																												
F																																																																																																																												
<table><tr><th>SYMBOL</th><th>DESCRIPTION</th><th>SYMBOL</th><th>DESCRIPTION</th><th>SYMBOL</th><th>DESCRIPTION</th></tr><tr><td></td><td>FRAME CONNECTION</td><td></td><td>MAIN CONTACT OF A CIRCUIT BREAKER</td><td></td><td>RELAY WITH TWO MAKE CONTACTS, ONE OF THEM DELAYED WHEN OPERATING</td></tr><tr><td></td><td>EARTH CONNECTION</td><td></td><td>PASSING MAKE CONTACT CLOSING MOMENTARILY DURING OPERATION AND RELEASE</td><td></td><td>RELAY WITH TWO ACTUATORS AND A TWO STABLE POSITIONS</td></tr><tr><td></td><td>RESISTOR</td><td></td><td>BREAK CONTACT DELAYED WHEN OPERATING</td><td></td><td></td></tr><tr><td></td><td>VARIABLE RESISTOR</td><td></td><td>MAKE CONTACT DELAYED WHEN RELEASING</td><td></td><td>SIGNALLING LAMP</td></tr><tr><td></td><td>RESISTOR WITH PRESET ADJUSTMENT</td><td></td><td>TWO MECHANICAL LINKS CROSSING WITHOUT CONNECTION</td><td></td><td>MECHANICAL INDICATOR WITH AUTOMATIC RESET</td></tr><tr><td></td><td>CAPACITOR</td><td></td><td>JUNCTION OF MECHANICAL LINKS</td><td></td><td>MECHANICAL INDICATOR WITH NON-AUTOMATIC RESET</td></tr><tr><td></td><td>SEMICONDUCTOR DIODE USED AS A CAPACITIVE DEVICE</td><td></td><td>AUTOMATIC RESET</td><td></td><td>ELECTRICALLY CONTROLLED MECHANICAL INDICATOR WITH AUTOMATIC RESET</td></tr><tr><td></td><td>OPEN CONTACT, MAKE CONTACT</td><td></td><td>NON-AUTOMATIC RESET</td><td></td><td>ELECTRICALLY CONTROLLED MECHANICAL INDICATOR WITH NON-AUTOMATIC RESET</td></tr><tr><td></td><td>CLOSED CONTACT, BREAK CONTACT</td><td></td><td>SWITCHING DEVICE WITH MANUAL OPERATION AND WITH AUTOMATIC RESET</td><td></td><td>RELAY WITH MECHANICAL INDICATOR</td></tr><tr><td></td><td>CHANGE-OVER CONTACT, BREAK BEFORE MAKE</td><td></td><td>SWITCHING DEVICE WITH MANUAL OPERATION AND WITH NON-AUTOMATIC RESET</td><td></td><td>ELECTRO-MECHANICAL POSITION INDICATOR WITH ONE DE-ENERGIZED AND ONE OPERATED POSITION</td></tr><tr><td></td><td>MAKE CONTACT WHICH IS EARLY WHEN OPERATING AND LATE WHEN RELEASING</td><td></td><td>CHANGE-OVER SWITCHING DEVICE WITH MANUAL CONTROL</td><td></td><td>ELECTRO-MECHANICAL POSITION INDICATOR WITH ONE DE-ENERGIZED AND TWO OPERATED POSITION</td></tr><tr><td></td><td>BREAK CONTACT WHICH IS LATE WHEN OPERATING AND EARLY WHEN RELEASING</td><td></td><td>RELAY WITH MAKE CONTACT</td><td></td><td>BELL, BUZZER</td></tr><tr><td></td><td>SWITCHING DEVICE WITH MANUAL CONTROL</td><td></td><td>RELAY WITH CHANGE-OVER CONTACT</td><td></td><td>SIREN , HORN</td></tr><tr><td></td><td>MAKE CONTACT DELAYED WHEN OPERATING</td><td></td><td>RELAY WITH MAKE CONTACT, DELAYED WHEN OPERATING</td><td></td><td></td></tr><tr><td></td><td>BREAK CONTACT DELAYED WHEN RELEASING</td><td></td><td>RELAY WITH MAKE CONTACT, DELAYED WHEN RELEASING</td><td></td><td></td></tr><tr><td></td><td>MAKE CONTACT DELAYED WHEN OPERATING AND RELEASING</td><td></td><td>RELAY WITH MAKE CONTACT, DELAYED WHEN OPERATING AND RELEASING</td><td></td><td></td></tr><tr><td></td><td>MAIN CONTACT OF A SWITCH DISCONNECTOR</td><td></td><td></td><td></td><td></td></tr><tr><td></td><td>MAIN CONTACT OF A DISCONNECTOR</td><td></td><td></td><td></td><td></td></tr></table>											SYMBOL	DESCRIPTION	SYMBOL	DESCRIPTION	SYMBOL	DESCRIPTION		FRAME CONNECTION		MAIN CONTACT OF A CIRCUIT BREAKER		RELAY WITH TWO MAKE CONTACTS, ONE OF THEM DELAYED WHEN OPERATING		EARTH CONNECTION		PASSING MAKE CONTACT CLOSING MOMENTARILY DURING OPERATION AND RELEASE		RELAY WITH TWO ACTUATORS AND A TWO STABLE POSITIONS		RESISTOR		BREAK CONTACT DELAYED WHEN OPERATING				VARIABLE RESISTOR		MAKE CONTACT DELAYED WHEN RELEASING		SIGNALLING LAMP		RESISTOR WITH PRESET ADJUSTMENT		TWO MECHANICAL LINKS CROSSING WITHOUT CONNECTION		MECHANICAL INDICATOR WITH AUTOMATIC RESET		CAPACITOR		JUNCTION OF MECHANICAL LINKS		MECHANICAL INDICATOR WITH NON-AUTOMATIC RESET		SEMICONDUCTOR DIODE USED AS A CAPACITIVE DEVICE		AUTOMATIC RESET		ELECTRICALLY CONTROLLED MECHANICAL INDICATOR WITH AUTOMATIC RESET		OPEN CONTACT, MAKE CONTACT		NON-AUTOMATIC RESET		ELECTRICALLY CONTROLLED MECHANICAL INDICATOR WITH NON-AUTOMATIC RESET		CLOSED CONTACT, BREAK CONTACT		SWITCHING DEVICE WITH MANUAL OPERATION AND WITH AUTOMATIC RESET		RELAY WITH MECHANICAL INDICATOR		CHANGE-OVER CONTACT, BREAK BEFORE MAKE		SWITCHING DEVICE WITH MANUAL OPERATION AND WITH NON-AUTOMATIC RESET		ELECTRO-MECHANICAL POSITION INDICATOR WITH ONE DE-ENERGIZED AND ONE OPERATED POSITION		MAKE CONTACT WHICH IS EARLY WHEN OPERATING AND LATE WHEN RELEASING		CHANGE-OVER SWITCHING DEVICE WITH MANUAL CONTROL		ELECTRO-MECHANICAL POSITION INDICATOR WITH ONE DE-ENERGIZED AND TWO OPERATED POSITION		BREAK CONTACT WHICH IS LATE WHEN OPERATING AND EARLY WHEN RELEASING		RELAY WITH MAKE CONTACT		BELL, BUZZER		SWITCHING DEVICE WITH MANUAL CONTROL		RELAY WITH CHANGE-OVER CONTACT		SIREN , HORN		MAKE CONTACT DELAYED WHEN OPERATING		RELAY WITH MAKE CONTACT, DELAYED WHEN OPERATING				BREAK CONTACT DELAYED WHEN RELEASING		RELAY WITH MAKE CONTACT, DELAYED WHEN RELEASING				MAKE CONTACT DELAYED WHEN OPERATING AND RELEASING		RELAY WITH MAKE CONTACT, DELAYED WHEN OPERATING AND RELEASING				MAIN CONTACT OF A SWITCH DISCONNECTOR						MAIN CONTACT OF A DISCONNECTOR				
SYMBOL	DESCRIPTION	SYMBOL	DESCRIPTION	SYMBOL	DESCRIPTION																																																																																																																							
	FRAME CONNECTION		MAIN CONTACT OF A CIRCUIT BREAKER		RELAY WITH TWO MAKE CONTACTS, ONE OF THEM DELAYED WHEN OPERATING																																																																																																																							
	EARTH CONNECTION		PASSING MAKE CONTACT CLOSING MOMENTARILY DURING OPERATION AND RELEASE		RELAY WITH TWO ACTUATORS AND A TWO STABLE POSITIONS																																																																																																																							
	RESISTOR		BREAK CONTACT DELAYED WHEN OPERATING																																																																																																																									
	VARIABLE RESISTOR		MAKE CONTACT DELAYED WHEN RELEASING		SIGNALLING LAMP																																																																																																																							
	RESISTOR WITH PRESET ADJUSTMENT		TWO MECHANICAL LINKS CROSSING WITHOUT CONNECTION		MECHANICAL INDICATOR WITH AUTOMATIC RESET																																																																																																																							
	CAPACITOR		JUNCTION OF MECHANICAL LINKS		MECHANICAL INDICATOR WITH NON-AUTOMATIC RESET																																																																																																																							
	SEMICONDUCTOR DIODE USED AS A CAPACITIVE DEVICE		AUTOMATIC RESET		ELECTRICALLY CONTROLLED MECHANICAL INDICATOR WITH AUTOMATIC RESET																																																																																																																							
	OPEN CONTACT, MAKE CONTACT		NON-AUTOMATIC RESET		ELECTRICALLY CONTROLLED MECHANICAL INDICATOR WITH NON-AUTOMATIC RESET																																																																																																																							
	CLOSED CONTACT, BREAK CONTACT		SWITCHING DEVICE WITH MANUAL OPERATION AND WITH AUTOMATIC RESET		RELAY WITH MECHANICAL INDICATOR																																																																																																																							
	CHANGE-OVER CONTACT, BREAK BEFORE MAKE		SWITCHING DEVICE WITH MANUAL OPERATION AND WITH NON-AUTOMATIC RESET		ELECTRO-MECHANICAL POSITION INDICATOR WITH ONE DE-ENERGIZED AND ONE OPERATED POSITION																																																																																																																							
	MAKE CONTACT WHICH IS EARLY WHEN OPERATING AND LATE WHEN RELEASING		CHANGE-OVER SWITCHING DEVICE WITH MANUAL CONTROL		ELECTRO-MECHANICAL POSITION INDICATOR WITH ONE DE-ENERGIZED AND TWO OPERATED POSITION																																																																																																																							
	BREAK CONTACT WHICH IS LATE WHEN OPERATING AND EARLY WHEN RELEASING		RELAY WITH MAKE CONTACT		BELL, BUZZER																																																																																																																							
	SWITCHING DEVICE WITH MANUAL CONTROL		RELAY WITH CHANGE-OVER CONTACT		SIREN , HORN																																																																																																																							
	MAKE CONTACT DELAYED WHEN OPERATING		RELAY WITH MAKE CONTACT, DELAYED WHEN OPERATING																																																																																																																									
	BREAK CONTACT DELAYED WHEN RELEASING		RELAY WITH MAKE CONTACT, DELAYED WHEN RELEASING																																																																																																																									
	MAKE CONTACT DELAYED WHEN OPERATING AND RELEASING		RELAY WITH MAKE CONTACT, DELAYED WHEN OPERATING AND RELEASING																																																																																																																									
	MAIN CONTACT OF A SWITCH DISCONNECTOR																																																																																																																											
	MAIN CONTACT OF A DISCONNECTOR																																																																																																																											

AS-BUILT BY _____ DATE _____		CONTRACT NO. 11131113/00		JOB ORDER NO. S-13656		GRAPHICAL SYMBOLS FOR DIAGRAMS		الشركة الوطنية لنقل الكهرباء		نقل الكهرباء	
DRAWN BY RIZ CHECKED BY KVR		DATE STARTED 28.01.2013 DATE COMPLETED _____		S/S 8709 - 132/13.8KV IN AL-KHARJ CITY		132KV BUSBAR PROTN.MAIN-1 BU PANEL +8BP1-4		INDEX PLANT NO. DRAWING NUMBER		SHEET NO. REV. NO.	
PRG. DEPT. CTPD ENG. DEPT. AUT-PSAC				RIYADH SAUDI ARABIA		- C421 CD-322997		011 012		01	
REV. NO. DATE DESCRIPTION											
01 13 49 FACTORY ASBUILT											
00 13 05 FOR APPROVAL											



	1	2	3	4	5	6	7	8	9	10
A										
B										
C										
D										
E										
F										

SYMBOL	DESCRIPTION	SYMBOL	DESCRIPTION	SYMBOL	DESCRIPTION
	FUSE / LINK		WATTMETER		ELEMENT WITH NEGATED INHIBITING INPUT
	FUSE WITH THE SUPPLY SIDE INDICATED		VARMETER		ELEMENT WITH INPUT WHICH DOES NOT CARRY ANY LOGIC INFORMATION
	SINGLE-PHASE TRANSFORMER WITH TWO SEPARATE WINDINGS (TWO ALTERNATIVE FORMS)		POWER FACTOR METER		ELEMENT WITH POSTPONED OUTPUT
	SINGLE-PHASE TRANSFORMER WITH TWO SEPARATE WINDINGS (TWO ALTERNATIVE FORMS)		POSITION INDICATOR		AND-ELEMENT WITH TWO INPUTS
	SINGLE-PHASE TRANSFORMER WITH FERRO MAGNETIC CORE		SYNCHROSCOPE		OR-ELEMENT WITH TWO INPUTS
	SINGLE-PHASE VOLTAGE TRANSFORMER (MULTI-LINE AND SINGLE-LINE REPRESENTATION)		RECORDING VOLTMETER		LOGIC THRESHOLD ELEMENT WITH FOUR INPUTS AND THRESHOLD VALUE 2
	SINGLE-PHASE VOLTAGE TRANSFORMER WITH TWO SECONDARY WINDINGS (MULTI-LINE AND SINGLE-LINE REPRESENTATION)		RECORDING WATTMETER		ELEMENT WITH THREE INPUTS FOR "2 AND ONLY 2"
	CURRENT TRANSFORMER (MULTI-LINE AND SINGLE-LINE REPRESENTATION)		HOUR METER		EXCLUSIVE OR-ELEMENT WITH THREE INPUTS
	CURRENT TRANSFORMER WITH TWO CORES (MULTI-LINE AND SINGLE-LINE REPRESENTATION)		WATT-HOUR METER		LOGIC IDENTITY ELEMENT WITH THREE INPUTS
	CURRENT TRANSFORMER WITH TWO SECONDARY WINDINGS ON ONE CORE (MULTI-LINE AND SINGLE-LINE REPRESENTATION)		WATT-HOUR METER FOR ENERGY FROM A BUSBAR SYSTEM		MAJORITY ELEMENT WITH THREE INPUTS
	FILTER		ELEMENT WITH STATIC INPUT		NEGATOR
	HIGH-PASS FILTER		ELEMENT WITH STATIC NEGATED INPUT		NAND ELEMENT WITH TWO INPUTS
	BAND-PASS FILTER		ELEMENT WITH STATIC NEGATED OUTPUT		NOR ELEMENT WITH TWO INPUTS
	VOLTMETER		ELEMENT WITH DYNAMIC INPUT		BISTABLE ELEMENT
	AMMETER		ELEMENT WITH DYNAMIC NEGATED INPUT		
			ELEMENT WITH INHIBITING INPUT		

AS-BUILT BY _____ DATE _____			CONTRACT NO. 11131113/00		JOB ORDER NO. S-13656		GRAPHICAL SYMBOLS FOR DIAGRAMS			نقل الكهرباء الشركة الوطنية لنقل الكهرباء National Grid sa		
01	13 49	FACTORY ASBUILT	DRAWN BY RIZ	CHECKED BY KVR	132KV BUSBAR PROTN.MAIN-1 BU PANEL +BBP1-4			INDEX	PLANT NO.	DRAWING NUMBER	SHEET NO.	REV. NO.
00	13 05	FOR APPROVAL	DATE STARTED 28.01.2013	DATE COMPLETED	S/S 8709 - 132/13.8KV IN AL-KHARJ CITY			-	C421	CD-322997	012 013	01
REV. NO.	DATE	DESCRIPTION	OPRG. DEPT. CTPD	ENG. DEPT. AUT-PSAC	RIYADH SAUDI ARABIA							

## LEGENDS

±R1	DC SUPPLY - MAIN PROTECTION
±R2	DC SUPPLY - SECONDARY PROTECTION
±R3	DC SUPPLY - BACK UP PROTECTION
±IT	DC SUPPLY - INTER TRIP
FL	DC SUPPLY - FLASHING CIRCUIT
BB RS±	DC SUPPLY - BUS BAR - PROTECTION RESET
BB CBF±/CBF±	DC SUPPLY - CBF PROTECTION
R	RESET BUS - ALARM SYSTEM
CR	CONTROL ROOM
ECC	ENERGY CONTROL CENTRE
LOCAL	THE LOCATION OF CONTROLLED DEVICE
REMOTE	ANY OTHER LOCATION NOT LOCAL
ON	CB NORMALLY OPEN AUXILIARY CONTACT
OFF	CB NORMALLY CLOSED AUXILIARY CONTACT
A	COMMON
T	TEST POSITION
S	SERVICE POSITION
CS	CLOSE IN SERVICE POSITION
CT	CLOSE IN TEST POSITION
LS	LOCAL SERVICE
LT	LOCAL TEST
LC	LOCAL CLOSE
LO	LOCAL OPEN
RO	REMOTE OPEN
OP	OPERATE
RE	RESET

## NOTES

### LABELS

WHITE LABEL WITH BLACK LETTERING WILL BE PROVIDED FOR ALL MOUNTED APPARATUS EQUIPMENT IDENTIFICATION AND FUNCTION REFERENCE LABEL WILL BE PROVIDED FOR FRONT MOUNTED EQUIPMENTS OF THE PANEL AND EQUIPMENT IDENTIFICATION LABEL WILL BE PROVIDED FOR INTERNALLY MOUNTED EQUIPMENTS

### WIRING

PVC INSULATED 600V GRADE  
 2.5 SQ.mm. YELLOW COLOURED FOR CT CIRCUITS  
 2.5 SQ.mm. RE COLOURED FOR VT CIRCUITS  
 1.5 SQ.mm. GREY COLOURED FOR DC SUPPLY, SCADA AND CONTROL CIRCUITS  
 2.5 SQ.mm. BLACK COLOURED FOR AVC AND AC CIRCUITS  
 2.5 SQ.mm. YELLOW/GREEN COLOURED FOR EARTHING CONNECTIONS  
 FOLLOWING MARKERS SHALL BE PROVIDED ON FOLLOWING WIRES:  
 + SIGN FOR DC + WIRE  
 - SIGN FOR DC - WIRE

### LUGS


A. CT CIRCUITS- RING TYPE  
 B. OTHER CIRCUITS - SPADE TYPE

### FERULLING

YELLOW TUBE 3.2 mm FOR 1.5SQ mm WIRES AND 4.2 FOR 2.5 SQ mm WIRES  
 ( AS PER 31 - TMSS-1, RE.0 )


AS-BUILT BY _____ DATE _____		CONTRACT NO. <b>11131113/00</b>		JOB ORDER NO. <b>S-13656</b>		<b>COMMON LEGEND</b>		الشركة الوطنية لنقل الكهرباء		نقل الكهرباء	
DRAWN BY <b>RIZ</b> CHECKED BY <b>KVR</b>		DATE STARTED <b>28.01.2013</b> DATE COMPLETED _____		S/S 8709 - 132/13.8KV IN AL-KHARJ CITY		132KV BUSBAR PROT.N.MAIN-1 BU PANEL +BBP1-4		National Grid sa		SHEET NO. REV. NO.	
FOR APPROVAL		OPRG. DEPT. <b>CTPD</b> ENG. DEPT. <b>AUT-PSAC</b>		RIYADH		SAUDI ARABIA		DRAWING NUMBER <b>CD-322997</b>		SHT CONT. <b>013 014</b>	
REV. NO.	DATE	DESCRIPTION						INDEX <b>-</b> PLANT NO. <b>C421</b>		REV. NO. <b>01</b>	

FOR 132kV RELAY & CONTROL, PROT. PANELS

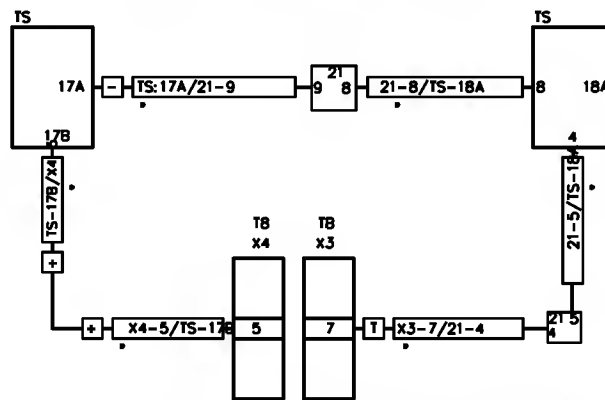

AS PER IEC-391 FIG 14a (W/O SUPPLEMENTARY/IDENTIFICATION MARK)

FOR 132kV PANELS INTERPANEL WIRING

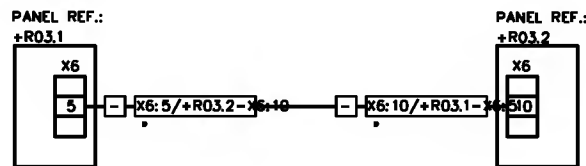

AS PER IEC-391 FIG 14d (W/O SUPPLEMENTARY/IDENTIFICATION MARK)

WIRES -  
PVC insulated, stranded,  
coiled annealed copper  
conductor graded for 1000V

a. CT Circuits - 2.5 Sqmm PVC Yellow colour

b. VT Circuits - 1.5 Sqmm PVC Red colour

c. DC, & CONTROL Circuits - 1.5 Sqmm  
PVC Grey colour

d. Alarm Circuits - 1.0 Sqmm PVC Blue colour

e. AVC & AC Circuits - 2.5 Sqmm PVC Black colour

f. Earth Circuits - 2.5 Sqmm PVC Yellow/Green colour

LUGS -  
Pre-insulated

a) CT Circuits - Ring type

b) Other Circuits - Spode type

- NOTE:1 ADDITIONAL MARKING AS APPLICABLE  
NOTE:2 FERRULE NUMBERING WILL BE BLACK LETTERS ON YELLOW TUBE  
3.2 mm for 1.5 sq mm wires and  
4.2 mm for 2.5 sq mm wires  
( As per 31-TWSS-1, REV 0 )  
NOTE:3 STARTING POINT OF THE FERRULE LEFT TO RIGHT

AS-BUILT BY \_\_\_\_\_ DATE \_\_\_\_\_ CONTRACT NO. 11131113/00 JOB ORDER NO. S-13656

01	13 49	FACTORY ASBUILT
00	13 05	FOR APPROVAL
REV. NO.	DATE	DESCRIPTION

DRAWN BY RIZ CHECKED BY KVR  
DATE STARTED 28.01.2013 DATE COMPLETED \_\_\_\_\_  
OPRG. DEPT. CTPD ENG. DEPT. AUT-PSAC


FERRULE AND WIRING DETAILS

132KV BUSBAR PROT.N.MAIN-1 BU PANEL +BBP1-4  
S/S 8709 - 132/13.8KV IN AL-KHARJ CITY  
RIYADH SAUDI ARABIA




الشركة الوطنية لنقل الكهرباء




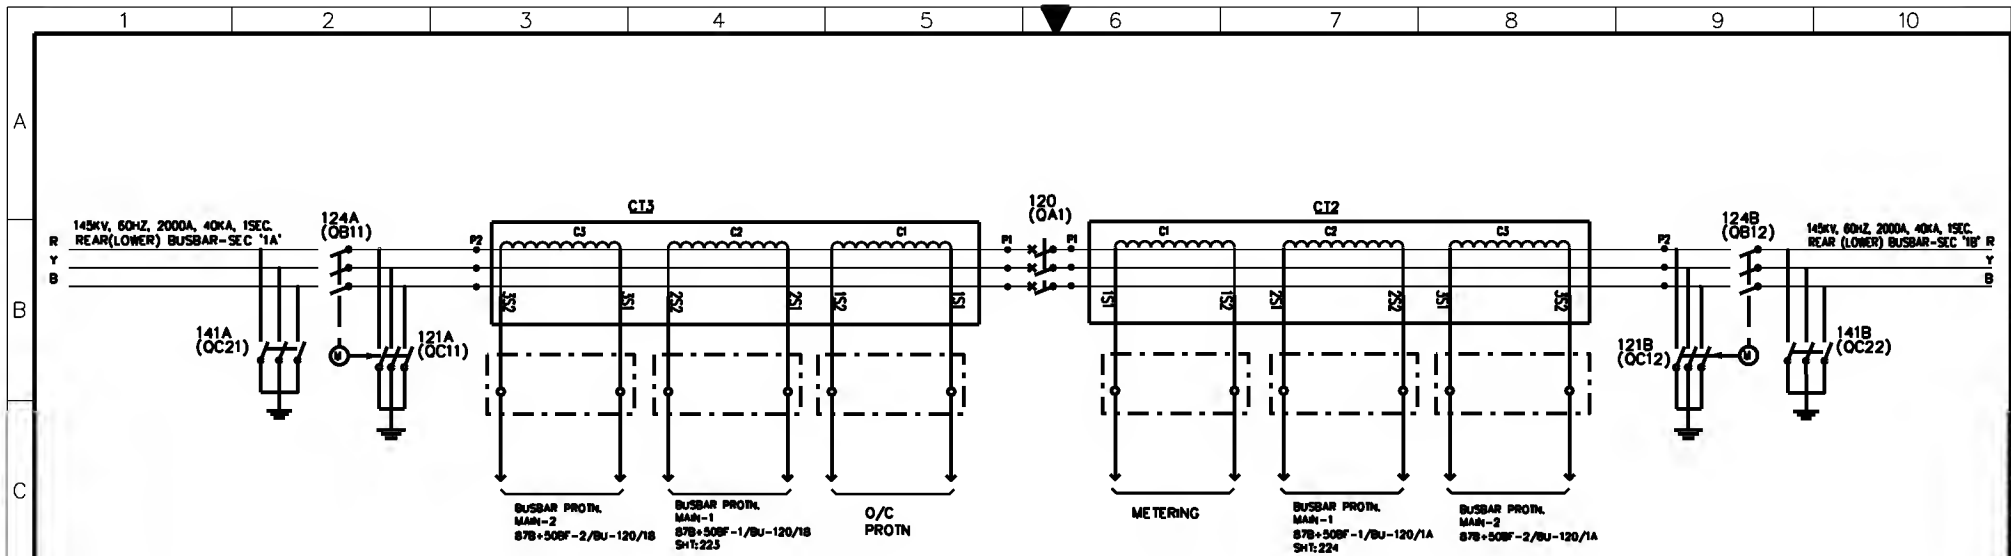
INDEX	PLANT NO.	DRAWING NUMBER	SHEET NO.	REV. NO.
-	C421	CD-322997	014	015

	1	2	3	4	5	6	7	8	9	10																																																																																																																					
A	<div style="text-align: center;">  <p>PROTECTION &amp; SUBSTATION AUTOMATION</p> </div> <table border="1"> <thead> <tr> <th>MANUFACTURER</th> <th>SCHEMATICS OWG.NO</th> <th>PANEL DESCRIPTION</th> <th>PANEL REFERENCE</th> </tr> </thead> <tbody> <tr> <td></td> <td></td> <td>SS 8709 132kV RELAY PANELS</td> <td></td> </tr> <tr> <td rowspan="2">CD-322928</td> <td></td> <td>132/13.8kV GT-1 RELAY PANEL -1</td> <td>+R05.1</td> </tr> <tr> <td></td> <td>132/13.8kV GT-1 RELAY PANEL -2</td> <td>+R05.2</td> </tr> <tr> <td rowspan="2">CD-322931</td> <td></td> <td>132/13.8kV GT-2 RELAY PANEL -1</td> <td>+R01.1</td> </tr> <tr> <td></td> <td>132/13.8kV GT-2 RELAY PANEL -2</td> <td>+R01.2</td> </tr> <tr> <td rowspan="2">CD-322934</td> <td></td> <td>132/13.8kV GT-3 RELAY PANEL -1</td> <td>+R04.1</td> </tr> <tr> <td></td> <td>132/13.8kV GT-3 RELAY PANEL -2</td> <td>+R04.2</td> </tr> <tr> <td>CD-322936</td> <td></td> <td>132/13.8kV TRANSFORMER-1,2&amp; 3 AVC PANEL</td> <td>+AVC</td> </tr> <tr> <td rowspan="2">CD-322922</td> <td></td> <td>132KV SPARE-1 UGF RELAY PANEL -1</td> <td>+R07.1</td> </tr> <tr> <td></td> <td>132KV SPARE-1 UGF RELAY PANEL -2</td> <td>+R07.2</td> </tr> <tr> <td rowspan="2">CD-322916</td> <td></td> <td>132KV 8020 UGF RELAY PANEL -1</td> <td>+R02.1</td> </tr> <tr> <td></td> <td>132KV 8020 UGF RELAY PANEL -2</td> <td>+R02.2</td> </tr> <tr> <td rowspan="2">CD-322919</td> <td></td> <td>132KV 8710 UGF RELAY PANEL -1</td> <td>+R03.1</td> </tr> <tr> <td></td> <td>132KV 8710 UGF RELAY PANEL -2</td> <td>+R03.2</td> </tr> <tr> <td rowspan="2">CD-322925</td> <td></td> <td>132KV SPARE-2 UGF RELAY PANEL -1</td> <td>+R06.1</td> </tr> <tr> <td></td> <td>132KV SPARE-2 UGF RELAY PANEL -2</td> <td>+R06.2</td> </tr> <tr> <td>CD-323012</td> <td></td> <td>132KV FOP PANEL</td> <td>+FOP</td> </tr> <tr> <td>CD-322946</td> <td></td> <td>132kV BUS COUPLER-A</td> <td>+R130</td> </tr> <tr> <td>CD-322948</td> <td></td> <td>132kV BUS COUPLER-B</td> <td>+R230</td> </tr> <tr> <td>CD-322950</td> <td></td> <td>132kV BUS SECTION</td> <td>+R120</td> </tr> <tr> <td>CD-322991</td> <td></td> <td>132kV BUSBAR PROTECTION MAIN-1 CENTRAL UNIT PANEL</td> <td>+BBP1-1</td> </tr> <tr> <td>CD-322993</td> <td></td> <td>132kV BUSBAR PROTECTION MAIN-1 BAY UNIT PANEL</td> <td>+BBP1-2</td> </tr> <tr> <td>CD-322995</td> <td></td> <td>132kV BUSBAR PROTECTION MAIN-1 BAY UNIT PANEL</td> <td>+BBP1-3</td> </tr> <tr> <td>CD-322997</td> <td></td> <td>132kV BUSBAR PROTECTION MAIN-1 BAY UNIT PANEL</td> <td>+BBP1-4</td> </tr> <tr> <td>CD-322999</td> <td></td> <td>132kV BUSBAR PROTECTION MAIN-1 BAY UNIT PANEL</td> <td>+BBP1-5</td> </tr> <tr> <td>CD-323001</td> <td></td> <td>132kV BUSBAR PROTECTION MAIN-2 CENTRAL UNIT PANEL</td> <td>+BBP2-1</td> </tr> <tr> <td>CD-323003</td> <td></td> <td>132kV BUSBAR PROTECTION MAIN-2 BAY UNIT PANEL</td> <td>+BBP2-2</td> </tr> <tr> <td>CD-323005</td> <td></td> <td>132kV BUSBAR PROTECTION MAIN-2 BAY UNIT PANEL</td> <td>+BBP2-3</td> </tr> <tr> <td>CD-323007</td> <td></td> <td>132kV BUSBAR PROTECTION MAIN-2 BAY UNIT PANEL</td> <td>+BBP2-4</td> </tr> <tr> <td>CD-323009</td> <td></td> <td>132kV BUSBAR PROTECTION MAIN-2 BAY UNIT PANEL</td> <td>+BBP2-5</td> </tr> </tbody> </table>										MANUFACTURER	SCHEMATICS OWG.NO	PANEL DESCRIPTION	PANEL REFERENCE			SS 8709 132kV RELAY PANELS		CD-322928		132/13.8kV GT-1 RELAY PANEL -1	+R05.1		132/13.8kV GT-1 RELAY PANEL -2	+R05.2	CD-322931		132/13.8kV GT-2 RELAY PANEL -1	+R01.1		132/13.8kV GT-2 RELAY PANEL -2	+R01.2	CD-322934		132/13.8kV GT-3 RELAY PANEL -1	+R04.1		132/13.8kV GT-3 RELAY PANEL -2	+R04.2	CD-322936		132/13.8kV TRANSFORMER-1,2& 3 AVC PANEL	+AVC	CD-322922		132KV SPARE-1 UGF RELAY PANEL -1	+R07.1		132KV SPARE-1 UGF RELAY PANEL -2	+R07.2	CD-322916		132KV 8020 UGF RELAY PANEL -1	+R02.1		132KV 8020 UGF RELAY PANEL -2	+R02.2	CD-322919		132KV 8710 UGF RELAY PANEL -1	+R03.1		132KV 8710 UGF RELAY PANEL -2	+R03.2	CD-322925		132KV SPARE-2 UGF RELAY PANEL -1	+R06.1		132KV SPARE-2 UGF RELAY PANEL -2	+R06.2	CD-323012		132KV FOP PANEL	+FOP	CD-322946		132kV BUS COUPLER-A	+R130	CD-322948		132kV BUS COUPLER-B	+R230	CD-322950		132kV BUS SECTION	+R120	CD-322991		132kV BUSBAR PROTECTION MAIN-1 CENTRAL UNIT PANEL	+BBP1-1	CD-322993		132kV BUSBAR PROTECTION MAIN-1 BAY UNIT PANEL	+BBP1-2	CD-322995		132kV BUSBAR PROTECTION MAIN-1 BAY UNIT PANEL	+BBP1-3	CD-322997		132kV BUSBAR PROTECTION MAIN-1 BAY UNIT PANEL	+BBP1-4	CD-322999		132kV BUSBAR PROTECTION MAIN-1 BAY UNIT PANEL	+BBP1-5	CD-323001		132kV BUSBAR PROTECTION MAIN-2 CENTRAL UNIT PANEL	+BBP2-1	CD-323003		132kV BUSBAR PROTECTION MAIN-2 BAY UNIT PANEL	+BBP2-2	CD-323005		132kV BUSBAR PROTECTION MAIN-2 BAY UNIT PANEL	+BBP2-3	CD-323007		132kV BUSBAR PROTECTION MAIN-2 BAY UNIT PANEL	+BBP2-4	CD-323009		132kV BUSBAR PROTECTION MAIN-2 BAY UNIT PANEL	+BBP2-5
MANUFACTURER											SCHEMATICS OWG.NO	PANEL DESCRIPTION	PANEL REFERENCE																																																																																																																		
												SS 8709 132kV RELAY PANELS																																																																																																																			
CD-322928												132/13.8kV GT-1 RELAY PANEL -1	+R05.1																																																																																																																		
												132/13.8kV GT-1 RELAY PANEL -2	+R05.2																																																																																																																		
CD-322931												132/13.8kV GT-2 RELAY PANEL -1	+R01.1																																																																																																																		
												132/13.8kV GT-2 RELAY PANEL -2	+R01.2																																																																																																																		
CD-322934												132/13.8kV GT-3 RELAY PANEL -1	+R04.1																																																																																																																		
												132/13.8kV GT-3 RELAY PANEL -2	+R04.2																																																																																																																		
CD-322936												132/13.8kV TRANSFORMER-1,2& 3 AVC PANEL	+AVC																																																																																																																		
CD-322922												132KV SPARE-1 UGF RELAY PANEL -1	+R07.1																																																																																																																		
												132KV SPARE-1 UGF RELAY PANEL -2	+R07.2																																																																																																																		
CD-322916												132KV 8020 UGF RELAY PANEL -1	+R02.1																																																																																																																		
												132KV 8020 UGF RELAY PANEL -2	+R02.2																																																																																																																		
CD-322919												132KV 8710 UGF RELAY PANEL -1	+R03.1																																																																																																																		
												132KV 8710 UGF RELAY PANEL -2	+R03.2																																																																																																																		
CD-322925												132KV SPARE-2 UGF RELAY PANEL -1	+R06.1																																																																																																																		
												132KV SPARE-2 UGF RELAY PANEL -2	+R06.2																																																																																																																		
CD-323012												132KV FOP PANEL	+FOP																																																																																																																		
CD-322946												132kV BUS COUPLER-A	+R130																																																																																																																		
CD-322948												132kV BUS COUPLER-B	+R230																																																																																																																		
CD-322950												132kV BUS SECTION	+R120																																																																																																																		
CD-322991												132kV BUSBAR PROTECTION MAIN-1 CENTRAL UNIT PANEL	+BBP1-1																																																																																																																		
CD-322993												132kV BUSBAR PROTECTION MAIN-1 BAY UNIT PANEL	+BBP1-2																																																																																																																		
CD-322995		132kV BUSBAR PROTECTION MAIN-1 BAY UNIT PANEL	+BBP1-3																																																																																																																												
CD-322997		132kV BUSBAR PROTECTION MAIN-1 BAY UNIT PANEL	+BBP1-4																																																																																																																												
CD-322999		132kV BUSBAR PROTECTION MAIN-1 BAY UNIT PANEL	+BBP1-5																																																																																																																												
CD-323001		132kV BUSBAR PROTECTION MAIN-2 CENTRAL UNIT PANEL	+BBP2-1																																																																																																																												
CD-323003		132kV BUSBAR PROTECTION MAIN-2 BAY UNIT PANEL	+BBP2-2																																																																																																																												
CD-323005		132kV BUSBAR PROTECTION MAIN-2 BAY UNIT PANEL	+BBP2-3																																																																																																																												
CD-323007		132kV BUSBAR PROTECTION MAIN-2 BAY UNIT PANEL	+BBP2-4																																																																																																																												
CD-323009		132kV BUSBAR PROTECTION MAIN-2 BAY UNIT PANEL	+BBP2-5																																																																																																																												
B																																																																																																																															
C																																																																																																																															
D																																																																																																																															
E																																																																																																																															
F																																																																																																																															

AS-BUILT BY _____ DATE _____		CONTRACT NO. 11131113/00	JOB ORDER NO. S-13656	DRAWING REFERENCES		الشركة الوطنية لنقل الكهرباء		نقل الكهرباء	
01	13 49	FACTORY ASBUILT		DRAWN BY RIZ	CHECKED BY KVR	132KV BUSBAR PROTN.MAIN-1 BU PANEL +BBP1-4		National Grid sa	
00	13 05	FOR APPROVAL		DATE STARTED 28.01.2013 DATE COMPLETED _____		S/S 8709 - 132/13.8KV IN AL-KHARJ CITY		INDEX PLANT NO. DRAWING NUMBER SHEET NO. REV. NO.	
REV. NO.	DATE	DESCRIPTION		PRG. DEPT. CTPD ENG. DEPT. AUT-PSAC		- C421 CD-322997		015 016 01	


	1	2	3	4	5	6	7	8	9	10																																																	
A																																																											
B																																																											
C																																																											
D																																																											
E																																																											
F																																																											
G	<table border="1"> <tr> <td colspan="2">AS-BUILT BY _____ DATE _____</td> <td>CONTRACT NO. <b>11131113/00</b></td> <td>JOB ORDER NO. <b>S-13656</b></td> <td colspan="2"><b>DRAWING REFERENCES</b></td> <td colspan="4"> <b>الشركة الوطنية لنقل الكهرباء</b>   <b>نقل الكهرباء</b>  National Grid sa </td> </tr> <tr> <td><b>01</b></td> <td><b>13 49</b></td> <td colspan="2"><b>FACTORY ASBUILT</b></td> <td>DRAWN BY <b>RIZ</b></td> <td>CHECKED BY <b>KVR</b></td> <td colspan="2"><b>132KV BUSBAR PROTN.MAIN-1 BU PANEL +BBP1-4</b></td> <td>INDEX</td> <td>PLANT NO.</td> <td>DRAWING NUMBER</td> <td>SHEET NO.</td> <td>REV. NO.</td> </tr> <tr> <td><b>00</b></td> <td><b>13 05</b></td> <td colspan="2"><b>FOR APPROVAL</b></td> <td>DATE STARTED <b>28.01.2013</b></td> <td>DATE COMPLETED _____</td> <td colspan="2"><b>S/S 8709 - 132/13.8KV IN AL-KHARJ CITY</b></td> <td>-</td> <td><b>C421</b></td> <td><b>CD-322997</b></td> <td><b>016</b></td> <td><b>051</b></td> </tr> <tr> <td>REV. NO.</td> <td>DATE</td> <td colspan="2">DESCRIPTION</td> <td>OPRG. DEPT.</td> <td>ENG. DEPT.</td> <td colspan="2"><b>RIYADH SAUDI ARABIA</b></td> <td colspan="5"></td> </tr> </table>										AS-BUILT BY _____ DATE _____		CONTRACT NO. <b>11131113/00</b>	JOB ORDER NO. <b>S-13656</b>	<b>DRAWING REFERENCES</b>		<b>الشركة الوطنية لنقل الكهرباء</b>  <b>نقل الكهرباء</b> National Grid sa				<b>01</b>	<b>13 49</b>	<b>FACTORY ASBUILT</b>		DRAWN BY <b>RIZ</b>	CHECKED BY <b>KVR</b>	<b>132KV BUSBAR PROTN.MAIN-1 BU PANEL +BBP1-4</b>		INDEX	PLANT NO.	DRAWING NUMBER	SHEET NO.	REV. NO.	<b>00</b>	<b>13 05</b>	<b>FOR APPROVAL</b>		DATE STARTED <b>28.01.2013</b>	DATE COMPLETED _____	<b>S/S 8709 - 132/13.8KV IN AL-KHARJ CITY</b>		-	<b>C421</b>	<b>CD-322997</b>	<b>016</b>	<b>051</b>	REV. NO.	DATE	DESCRIPTION		OPRG. DEPT.	ENG. DEPT.	<b>RIYADH SAUDI ARABIA</b>						
AS-BUILT BY _____ DATE _____		CONTRACT NO. <b>11131113/00</b>	JOB ORDER NO. <b>S-13656</b>	<b>DRAWING REFERENCES</b>		<b>الشركة الوطنية لنقل الكهرباء</b>  <b>نقل الكهرباء</b> National Grid sa																																																					
<b>01</b>	<b>13 49</b>	<b>FACTORY ASBUILT</b>		DRAWN BY <b>RIZ</b>	CHECKED BY <b>KVR</b>	<b>132KV BUSBAR PROTN.MAIN-1 BU PANEL +BBP1-4</b>		INDEX	PLANT NO.	DRAWING NUMBER	SHEET NO.	REV. NO.																																															
<b>00</b>	<b>13 05</b>	<b>FOR APPROVAL</b>		DATE STARTED <b>28.01.2013</b>	DATE COMPLETED _____	<b>S/S 8709 - 132/13.8KV IN AL-KHARJ CITY</b>		-	<b>C421</b>	<b>CD-322997</b>	<b>016</b>	<b>051</b>																																															
REV. NO.	DATE	DESCRIPTION		OPRG. DEPT.	ENG. DEPT.	<b>RIYADH SAUDI ARABIA</b>																																																					

MANUFACTURER	SCHEMATICS DWG.NO	PANEL DESCRIPTION	PANEL REFERENCE
 PROTECTION & SUBSTATION AUTOMATION		SS 8709 13.8KV RELAY PANELS	
	CD-322952	13.8KV Copocitor Bank-1 Protection Panel	+CBP-1
	CD-322954	13.8KV Copocitor Bank-2 Protection Panel	+CBP-2
	CD-322956	13.8KV Copocitor Bank-2 Protection Panel	+CBP-3
	CD-322958	13.8 KV ACCS PANEL	+ACCS
	CD-322962	13.8KV ACSE PANEL	+ACSE
	CD-322968	13.8KV Under Voltage Load Shedding Panel	+UVLS
	CD-322964	13.8KV Under Frequency Load Shedding Panel-1	+UFLS01
	CD-322966	13.8KV Under Frequency Load Shedding Panel-2	+UFLS02



LOCATION OF GIS CT	CT	RATIO	CLASS	VK IN VOLT	Image IN mA @ VK	RCT IN OHMS	BURDEN IN VA	BURDEN IN VA
BUS 1A	CT3 CORE-1	2000/1A	0.2 ISF<10	--	--	--	30	CONTROL IED (BCU) + METERING
	CT3 CORE-2	2000/1A	x	>600 ol 2000/1A TAP	< = 25	<5	--	87B+50BF-1/BU-120/1B MAIN-1
	CT3 CORE-3	2000/1A	x	>600 ol 2000/1A TAP	< = 25	<5	--	87B+50BF-2/BU-120/1B MAIN-2
BUS 1B	CT2 CORE-1	2000/1A	x	>600 ol 2000/1A TAP	< = 25	<5	--	50+62BF+50/51+50/51N
	CT2 CORE-2	2000/1A	x	>600 ol 2000/1A TAP	< = 25	<5	--	87B+50BF-1/BU-120/1A MAIN-1
	CT2 CORE-3	2000/1A	x	>600 ol 2000/1A TAP	< = 25	<5	--	87B+50BF-2/BU-120/1A MAIN-2

AS-BUILT BY		DATE	CONTRACT NO. 11131113/00	JOB ORDER NO. S-13656	PRIMARY SYSTEM-BUS SECTION 120		الشركة الوطنية لنقل الكهرباء		نقل الكهرباء	
01 13 49		FACTORY ASBUILT	DRAWN BY RIZ CHECKED BY KVR		132KV BUSBAR PROT.MAIN-1 BU PANEL +BBP1-4		National Grid sa			
00 13 05		FOR APPROVAL	DATE STARTED 28.01.2013 DATE COMPLETED		S/S 8709 - 132/13.8KV IN AL-KHARJ CITY					
REV. NO.		DATE	DESCRIPTION		PRG. DEPT. CTPD ENG. DEPT. AUT-PSAC		INDEX PLANT NO. C421		DRAWING NUMBER CD-322997	
					RIYADH SAUDI ARABIA		SHEET NO. 051		CONT. 052	
							REV. NO. 01			

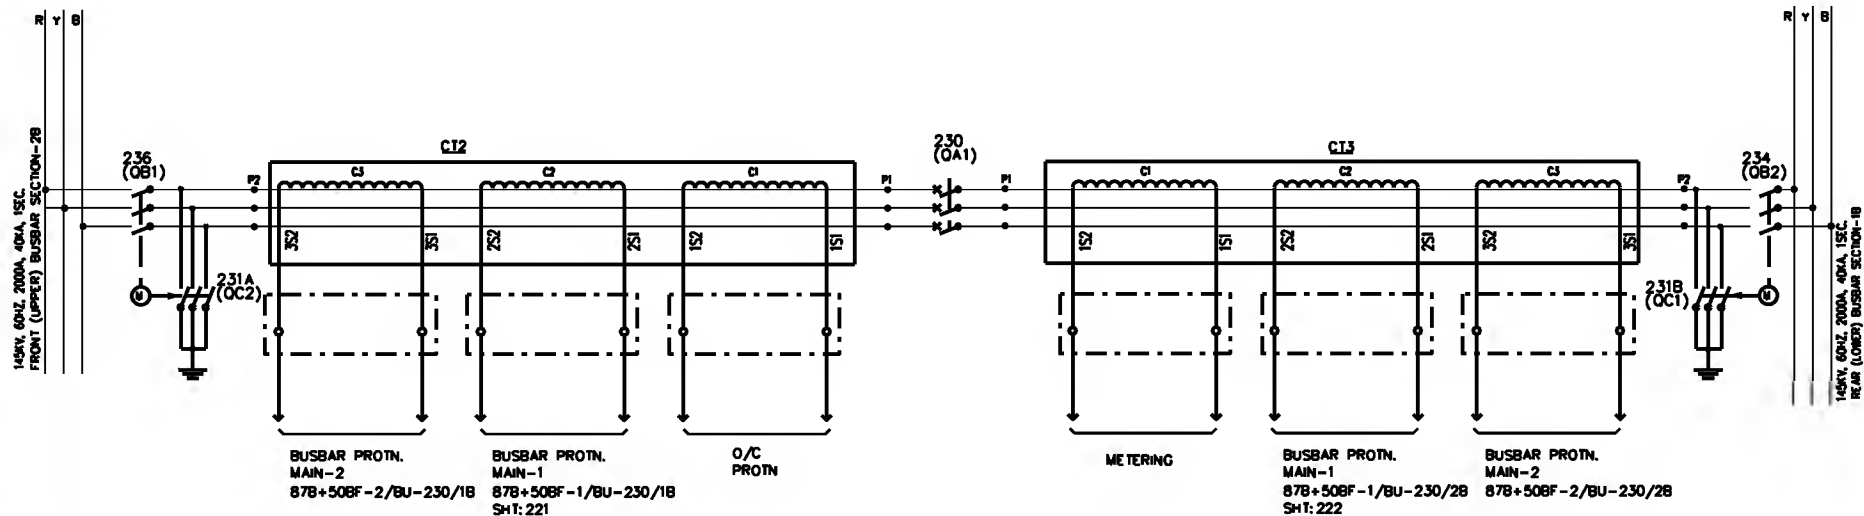

LOCATION OF GIS CT	CT	RATIO	CLASS	VK IN VOLT	Image IN mA @ VK	RCT IN OHMS	BURDEN IN VA	BURDEN IN VA
BUS 18	CT3 CORE-1	2000/1A	0.2 ISF<10	--	--	--	30	CONTROL IEO (BCU) + METERING
	CT3 CORE-2	2000/1A	x	>600 of 2000/1A TAP	< = 25	<5	--	87B+508F-1/BU-230/28 MAIN-1
	CT3 CORE-3	2000/1A	x	>600 of 2000/1A TAP	< = 25	<5	--	87B+508F-2/BU-230/28 MAIN-2
BUS 28	CT2 CORE-1	2000/1A	x	>600 of 2000/1A TAP	< = 25	<5	--	50+628F+50/51+50/51N
	CT2 CORE-2	2000/1A	x	>600 of 2000/1A TAP	< = 25	<5	--	87B+508F-1/BU-230/18 MAIN-1
	CT2 CORE-3	2000/1A	x	>600 of 2000/1A TAP	< = 25	<5	--	87B+508F-2/BU-230/18 MAIN-2




AS-BUILT BY \_\_\_\_\_ DATE \_\_\_\_\_ CONTRACT NO. 1113113/00 JOB ORDER NO. S-13656

01	13 49	FACTORY ASBUILT
00	13 05	FOR APPROVAL
REV. NO.	DATE	DESCRIPTION

DRAWN BY RIZ CHECKED BY KVR  
 DATE STARTED 28.01.2013 DATE COMPLETED \_\_\_\_\_  
 OPRG. DEPT. CTPD ENG. DEPT. AUT-PSAC

**PRIMARY SYSTEM-BUS COUPLER 230**  
**132KV BUSBAR PROTN.MAIN-1 BU PANEL +BBP1-4**  
**S/S 8709 - 132/13.8KV IN AL-KHARJ CITY**  
**RIYADH SAUDI ARABIA**

الشركة الوطنية لنقل الكهرباء		نقل الكهرباء	
National Grid sa		National Grid sa	
INDEX	PLANT NO.	DRAWING NUMBER	SHEET NO.
-	C421	CD-322997	052
		CONT.	REV. NO.
		211	01

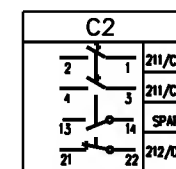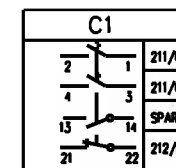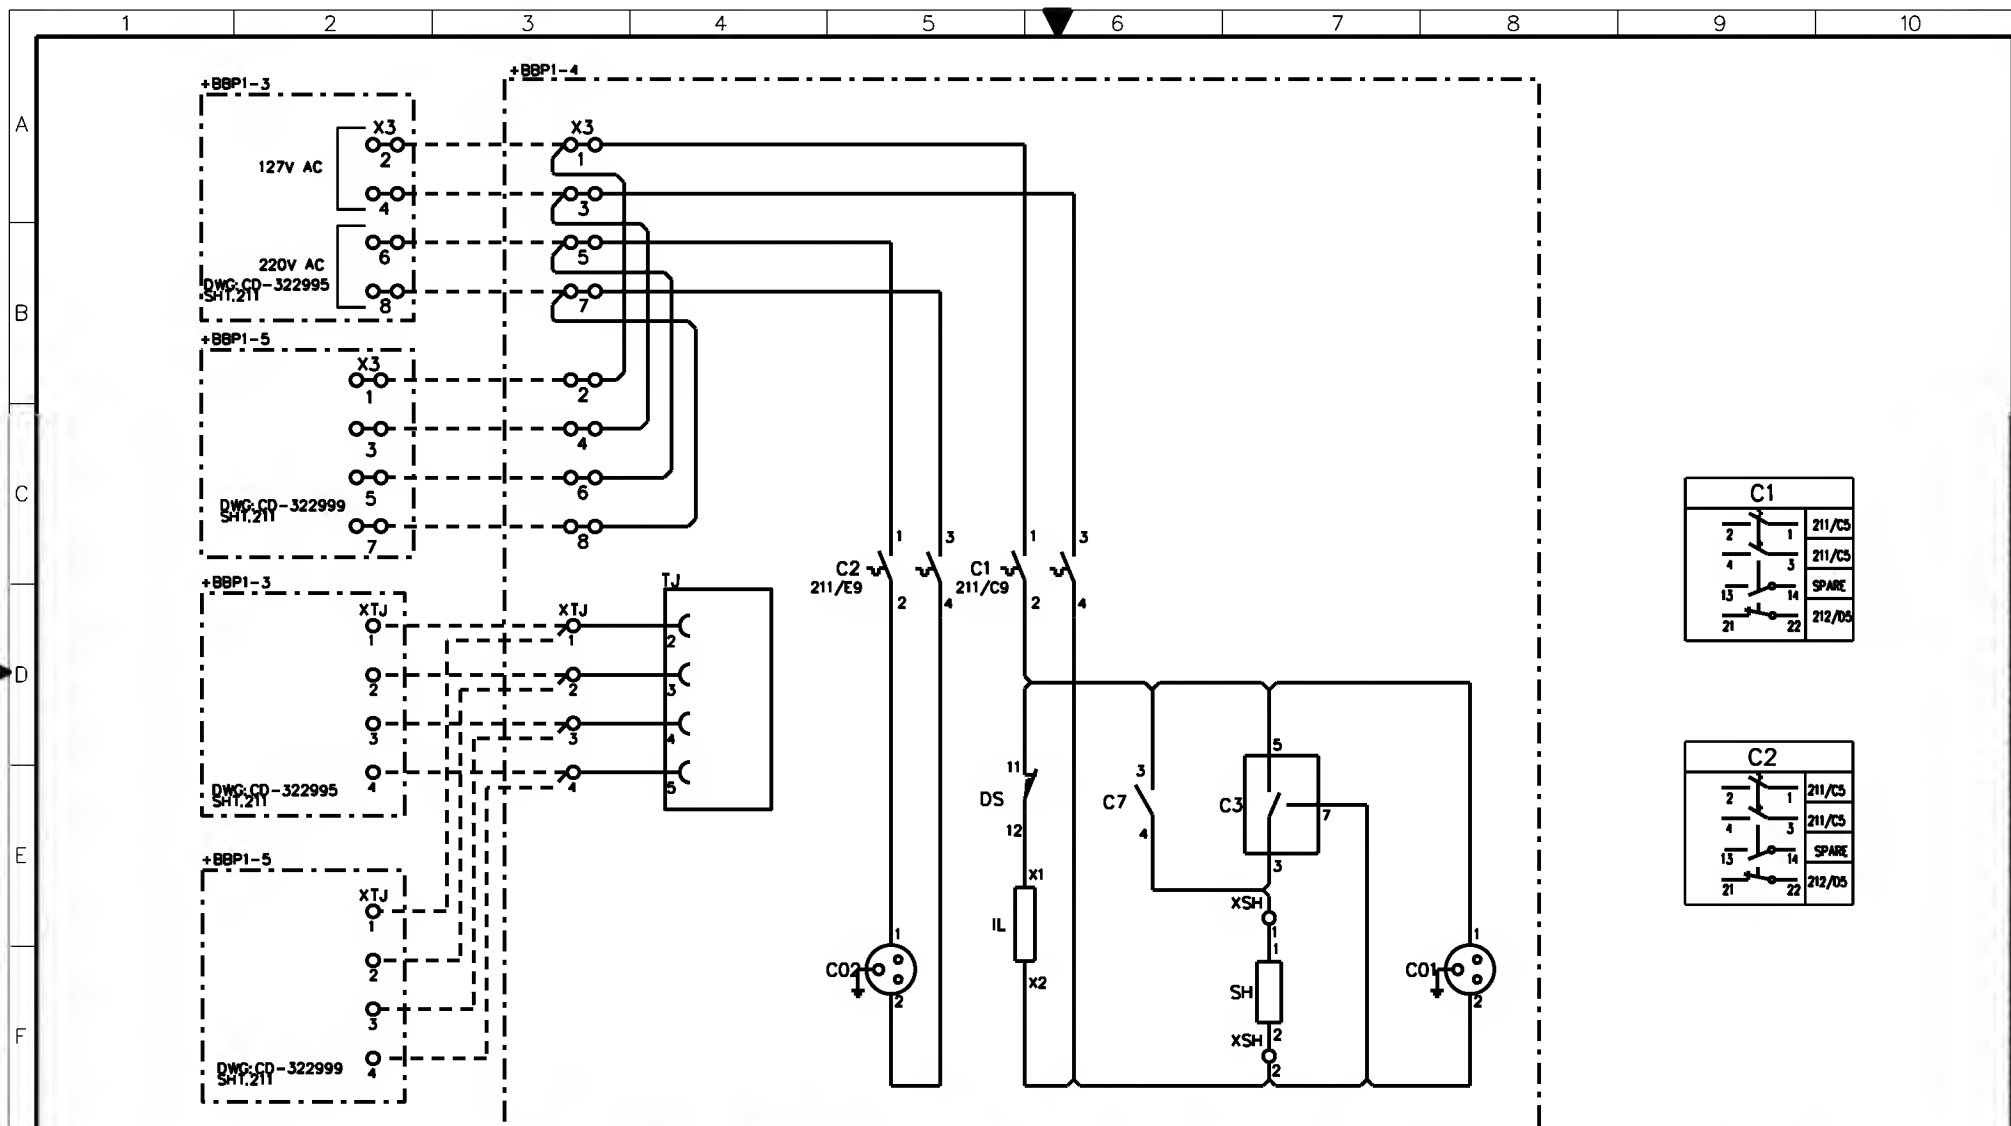

AS-BUILT BY

DATE

CONTRACT NO.

1113113/00

JOB ORDER NO.

S-13656

01

13 49

FACTORY ASBUILT

00

13 05

FOR APPROVAL

DRAWN BY

RIZ

CHECKED BY

KVR

DATE STARTED

28.01.2013

DATE COMPLETED

OPRG. DEPT.

CTPD

ENG. DEPT.

AUT-PSAC

AC SUPPLY FOR ILLUMINATION &POWER SOCKET

132KV BUSBAR PROT.N.MAIN-1 BU PANEL +BBP1-4

S/S 8709 - 132/13.8KV IN AL-KHARJ CITY

RIYADH SAUDI ARABIA

INDEX

PLANT NO.

DRAWING NUMBER

SHEET NO.

REV. NO.

-

C421

CD-322997

SHT

211

212

01

نقل الكهرباء

الشركة الوطنية لنقل الكهرباء

National Grid sa

01

13 49

FACTORY ASBUILT

00

13 05

FOR APPROVAL

DRAWN BY

RIZ

CHECKED BY

KVR

DATE STARTED

28.01.2013

DATE COMPLETED

OPRG. DEPT.

CTPD

ENG. DEPT.

AUT-PSAC

AC SUPPLY FOR ILLUMINATION &POWER SOCKET

132KV BUSBAR PROT.N.MAIN-1 BU PANEL +BBP1-4

S/S 8709 - 132/13.8KV IN AL-KHARJ CITY

RIYADH SAUDI ARABIA

INDEX

PLANT NO.

DRAWING NUMBER

SHEET NO.

REV. NO.

-

C421

CD-322997

SHT

211

212

01


نقل الكهرباء

الشركة الوطنية لنقل الكهرباء

National Grid sa




THIS DRAWING AND THE INFORMATION CONTAINED HEREIN ARE THE SOLE PROPERTY OF NATIONAL GRID SA. NO REPRODUCTION OR TRANSMISSION IN ANY FORM OR BY ANY MEANS, WITHOUT THE WRITTEN CONSENT OF ITS OWNER.



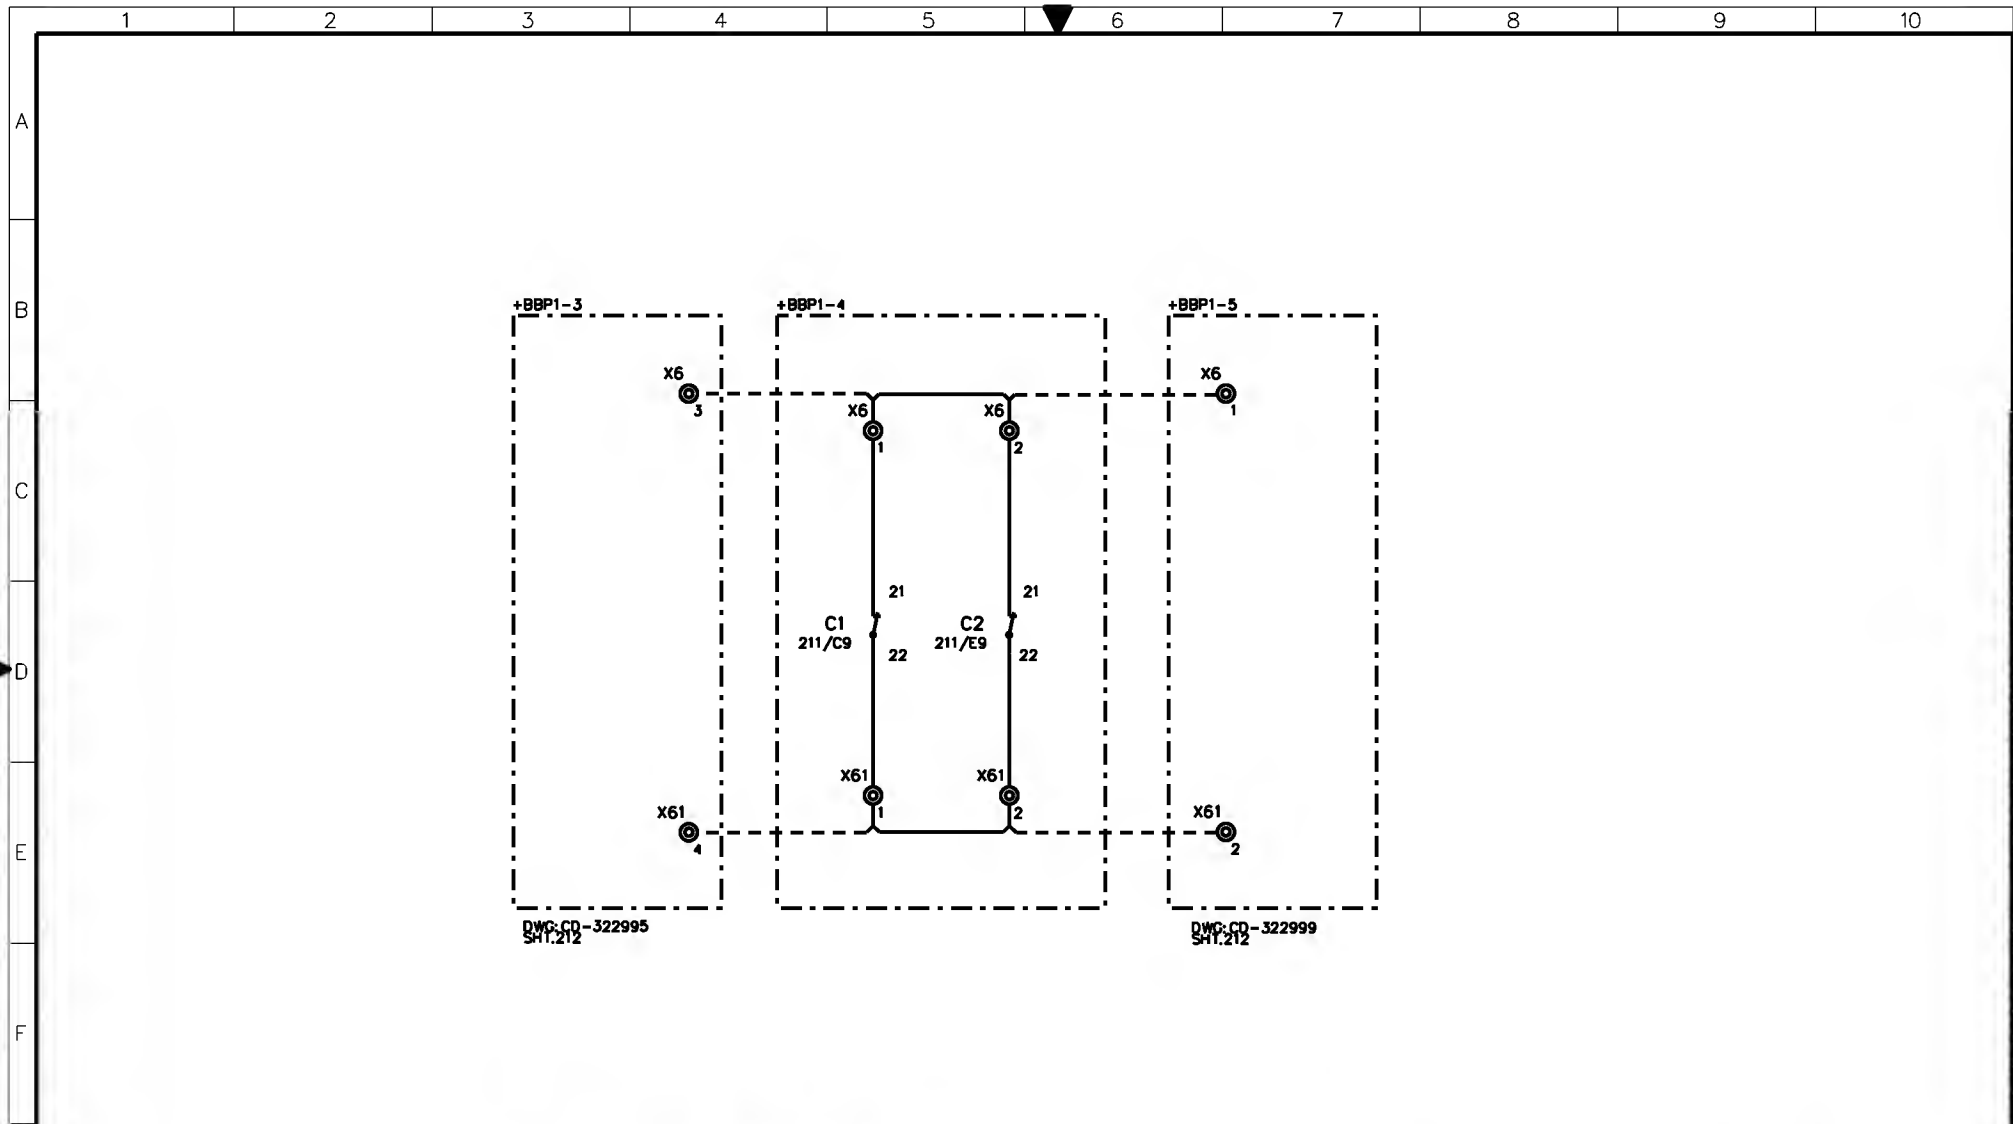


AS-BUILT BY _____ DATE _____			CONTRACT NO. <b>11131113/00</b>		JOB ORDER NO. <b>S-13656</b>		<b>CUB.LIGHTING,HEATER&amp;SOKET ALARM CKT.</b>				الشركة الوطنية لنقل الكهرباء			
DRAWN BY <b>RIZ</b> CHECKED BY <b>KVR</b>			DATE STARTED <b>28.01.2013</b> DATE COMPLETED _____		DATE STARTED _____ DATE COMPLETED _____		<b>132KV BUSBAR PROTN.MAIN-1 BU PANEL +BBP1-4</b>				National Grid sa			
FOR APPROVAL			DATE STARTED <b>28.01.2013</b> DATE COMPLETED _____		DATE STARTED _____ DATE COMPLETED _____		<b>S/S 8709 - 132/13.8KV IN AL-KHARJ CITY</b>				National Grid sa			
PRG. DEPT. <b>CTPD</b> ENG. DEPT. <b>AUT-PSAC</b>			PRG. DEPT. <b>CTPD</b> ENG. DEPT. <b>AUT-PSAC</b>		PRG. DEPT. <b>CTPD</b> ENG. DEPT. <b>AUT-PSAC</b>		<b>RIYADH SAUDI ARABIA</b>				National Grid sa			
REV. NO. _____ DATE _____			REV. NO. _____ DATE _____		REV. NO. _____ DATE _____		INDEX PLANT NO. DRAWING NUMBER SHEET NO. REV. NO.				National Grid sa			
01 13 49 FACTORY ASBUILT			00 13 05 FOR APPROVAL		00 13 05 FOR APPROVAL		- C421 CD-322997 212 216 01				National Grid sa			


THIS DRAWING AND THE INFORMATION CONTAINED HEREIN ARE THE SOLE PROPERTY OF NATIONAL GRID SA. NO REPRODUCTION OR TRANSMISSION IN ANY FORM OR BY ANY MEANS, WITHOUT THE WRITTEN CONSENT OF NATIONAL GRID SA, IS PERMITTED.

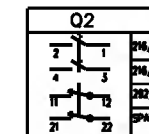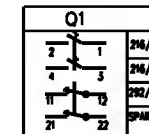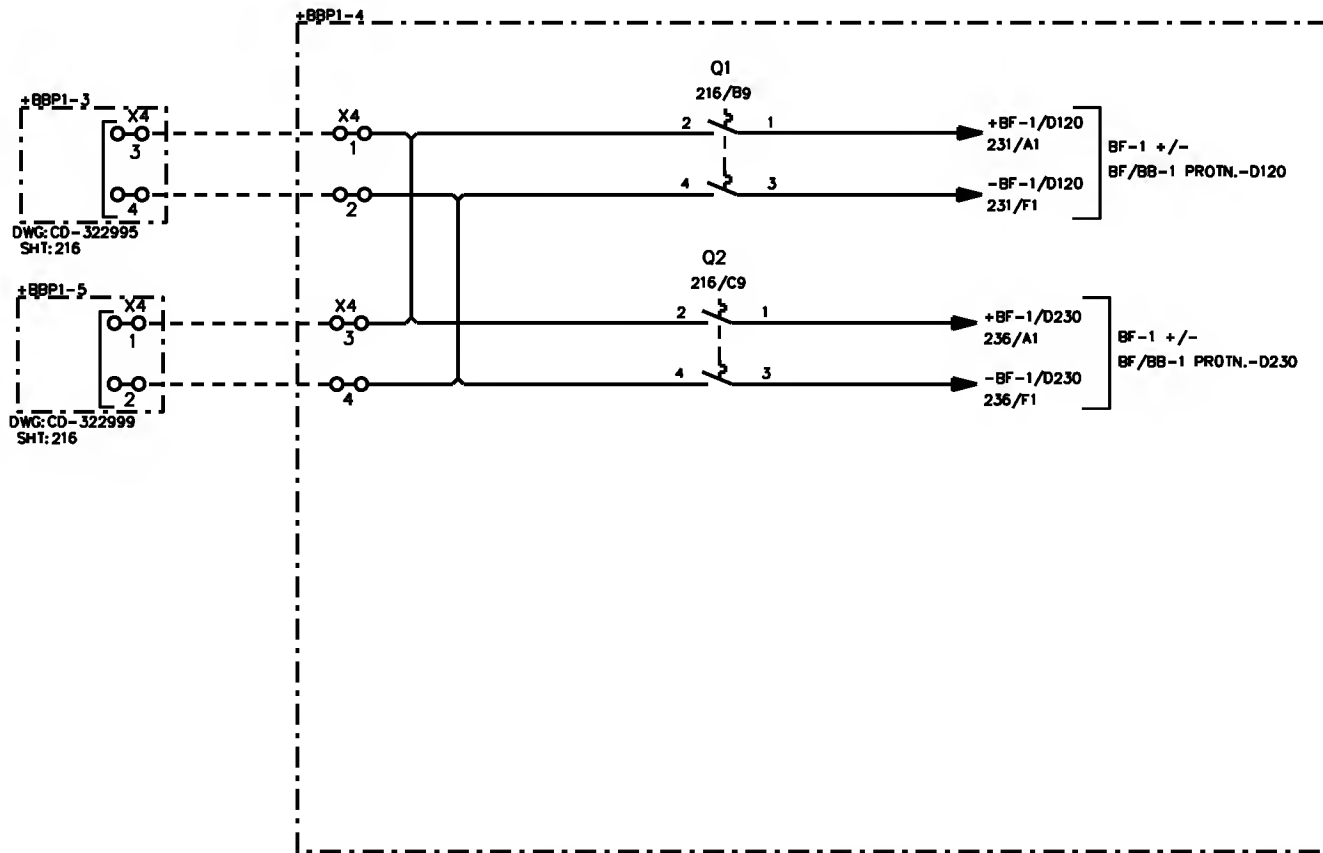

AS-BUILT BY _____ DATE _____			CONTRACT NO. 11131113/00		JOB ORDER NO. S-13656		DC SUPPLY DISTRIBUTION			نقل الكهرباء الشركة الوطنية لنقل الكهرباء National Grid SA		
DRAWN BY RIZ CHECKED BY KVR			DATE STARTED 28.01.2013 DATE COMPLETED _____			132KV BUSBAR PROTN.MAIN-1 BU PANEL +BBP1-4			INDEX PLANT NO. DRAWING NUMBER SHEET NO. REV. NO.			
DATE STARTED 28.01.2013 DATE COMPLETED _____			DATE STARTED _____ DATE COMPLETED _____			S/S 8709 - 132/13.8KV IN AL-KHARJ CITY			- C421 CD-322997 216 221 01			
PRG. DEPT. CTPD ENG. DEPT. AUT-PSAC			RİYADH SAUDI ARABIA			- C421 CD-322997 216 221 01			SHT CONT.			
REV. NO. DATE DESCRIPTION			FACTORY ASBUILT			FOR APPROVAL			NG/D2-D (2012/01)			

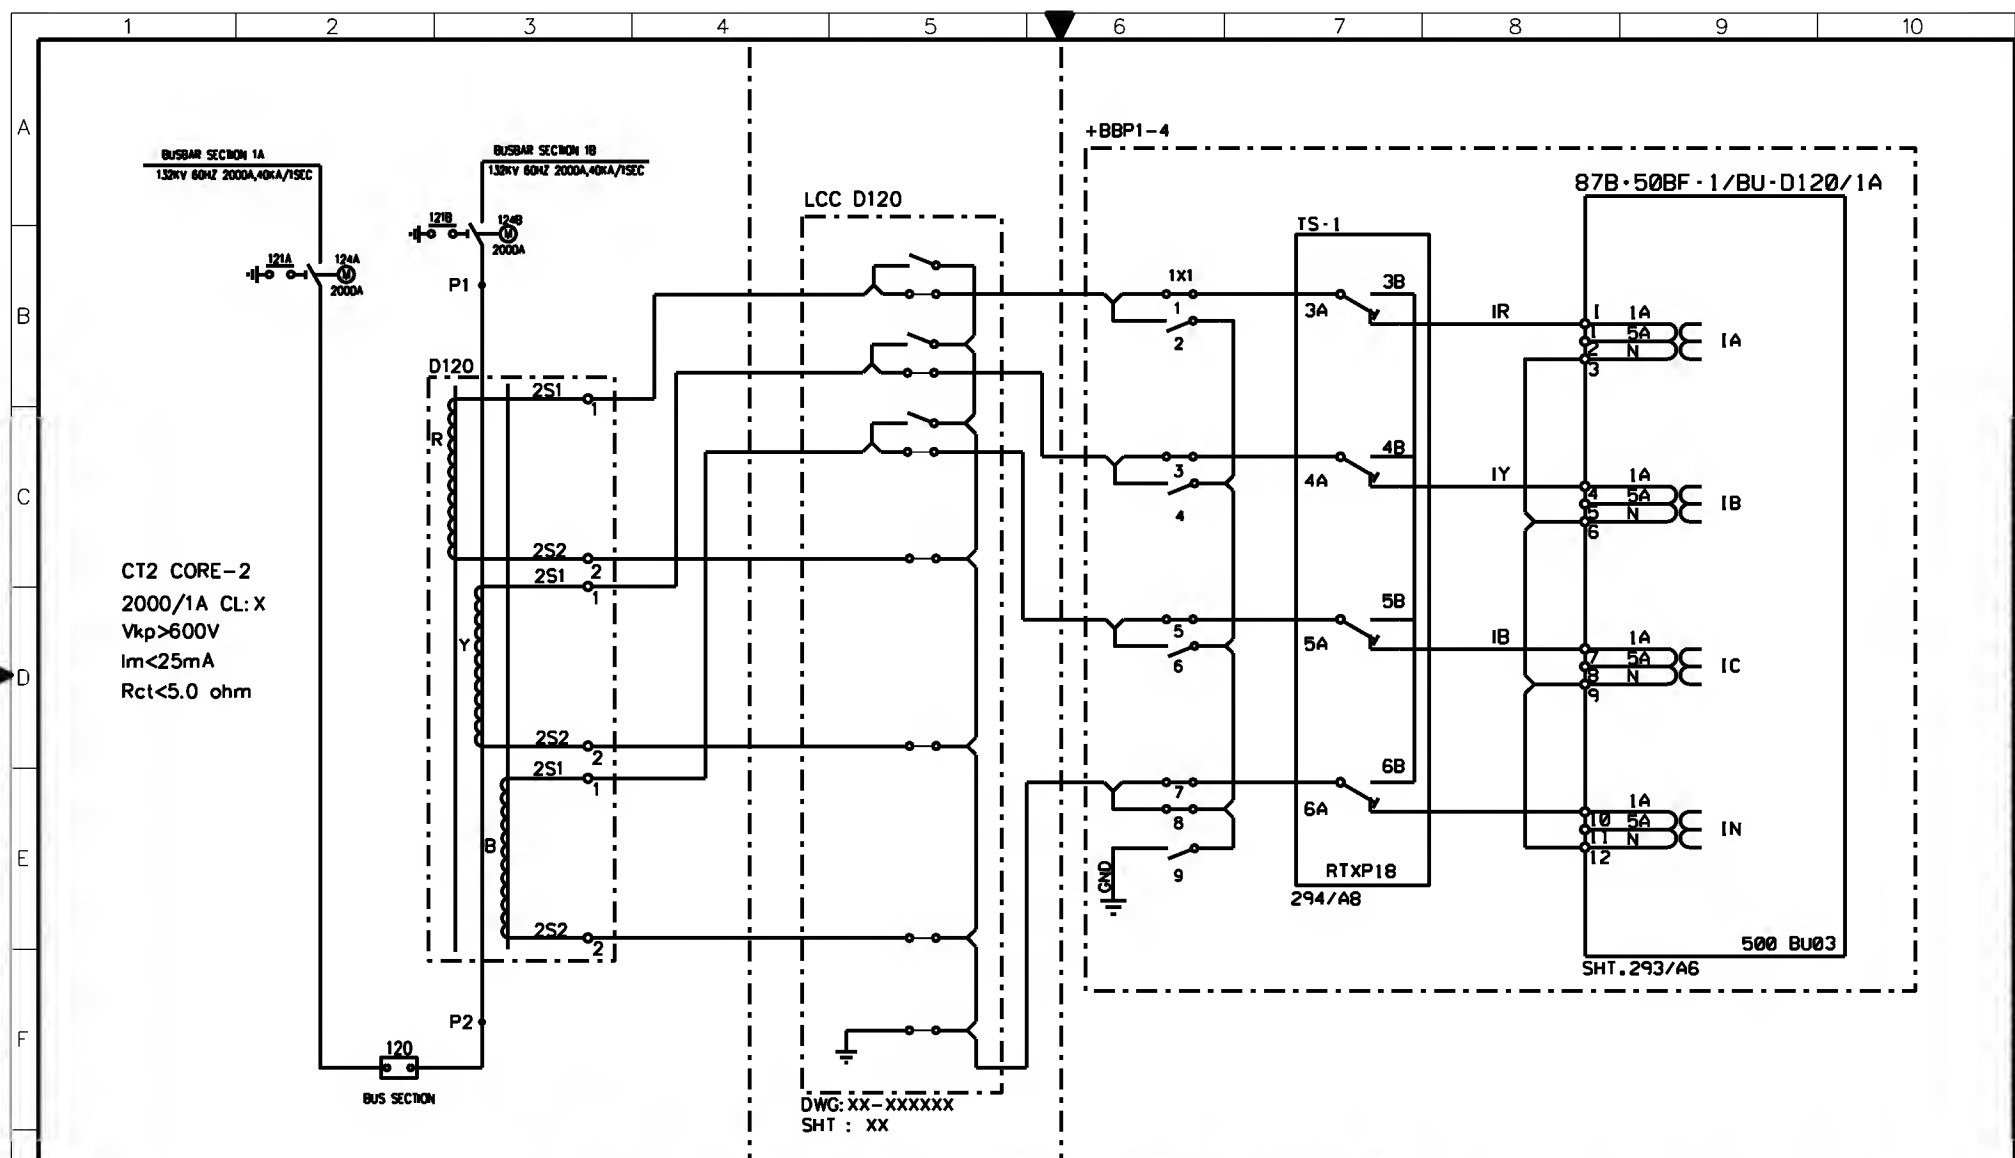

AS-BUILT BY _____ DATE _____		CONTRACT NO. 1113113/00	JOB ORDER NO. S-13656	CURRENT TRANSFORMER INPUTS -87B-50BF-1/BU-D120/1A		الشركة الوطنية لنقل الكهرباء		نقل الكهرباء	
01	13 49	FACTORY ASBUILT		DRAWN BY RIZ	CHECKED BY KVR	132KV BUSBAR PROTN.MAIN-1 BU PANEL +BBP1-4		National Grid sa	
00	13 05	FOR APPROVAL		DATE STARTED 28.01.2013	DATE COMPLETED _____	S/S 8709 - 132/13.8KV IN AL-KHARJ CITY		INDEX PLANT NO. DRAWING NUMBER	
REV. NO.	DATE	DESCRIPTION		OPRG. DEPT. CTPD	ENG. DEPT. AUT-PSAC	RIYADH SAUDI ARABIA		SHEET NO. REV. NO.	
						- C421		CD-322997	
								221 222	
								01	

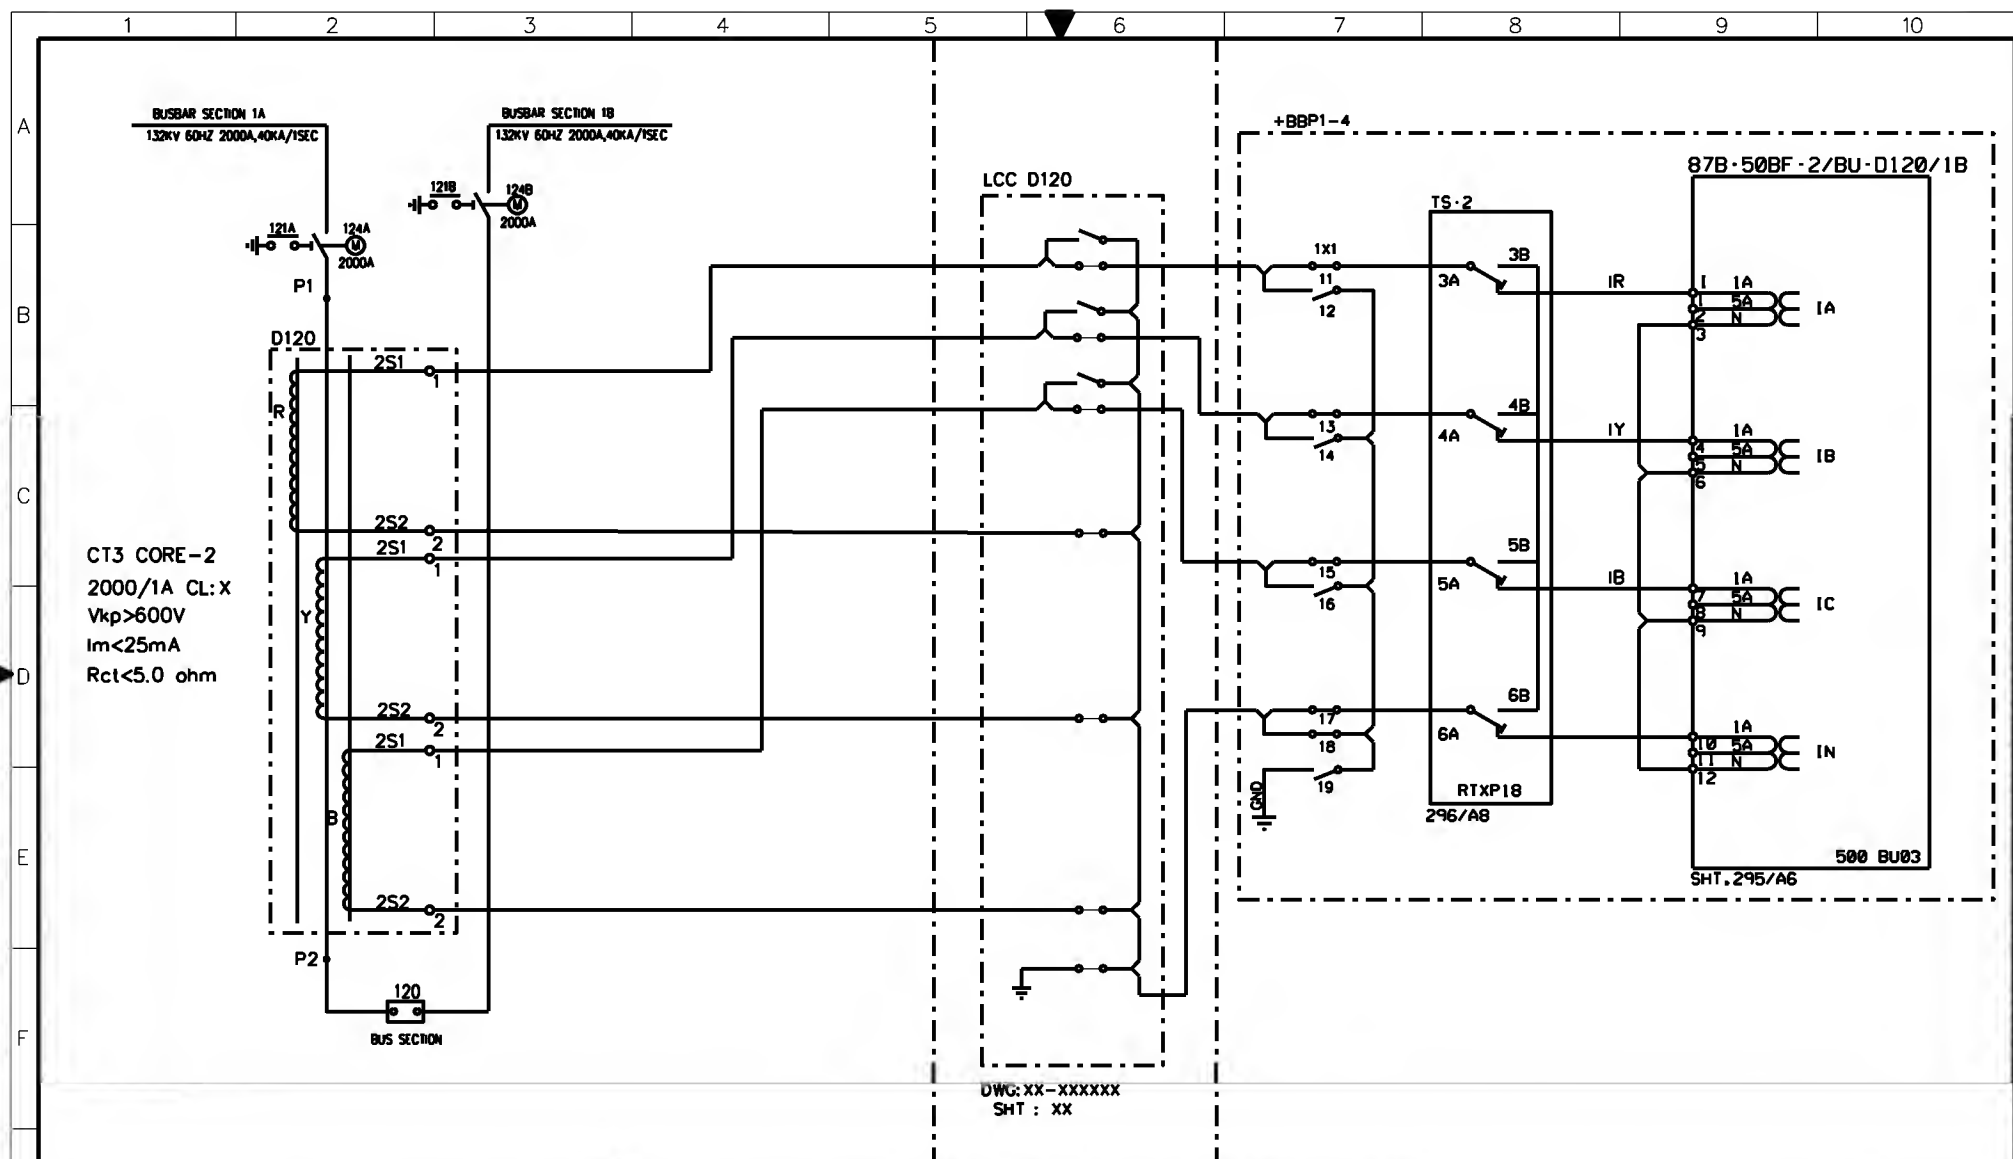

AS-BUILT BY \_\_\_\_\_ DATE \_\_\_\_\_

CONTRACT NO. 11131113/00

JOB ORDER NO. S-13656

0113 49FACTORY ASBUILT

0013 05FOR APPROVAL

REV. NO. DATE DESCRIPTION

DRAWN BY RIZ CHECKED BY KVR

DATE STARTED 28.01.2013 DATE COMPLETED \_\_\_\_\_

OPRG. DEPT. CTPD ENG. DEPT. AUT-PSAC

CURRENT TRANSFORMER INPUTS -87B-50BF-1/BU-D120/1B


132KV BUSBAR PROT.N.MAIN-1 BU PANEL +BBP1-4

S/S 8709 - 132/13.8KV IN AL-KHARJ CITY

RIYADH SAUDI ARABIA

نقل الكهرباء

الشركة الوطنية لنقل الكهرباء



National Grid sa

INDEX

PLANT NO.

DRAWING NUMBER

SHEET NO.

REV. NO.

-


C421

CD-322997

222223


01



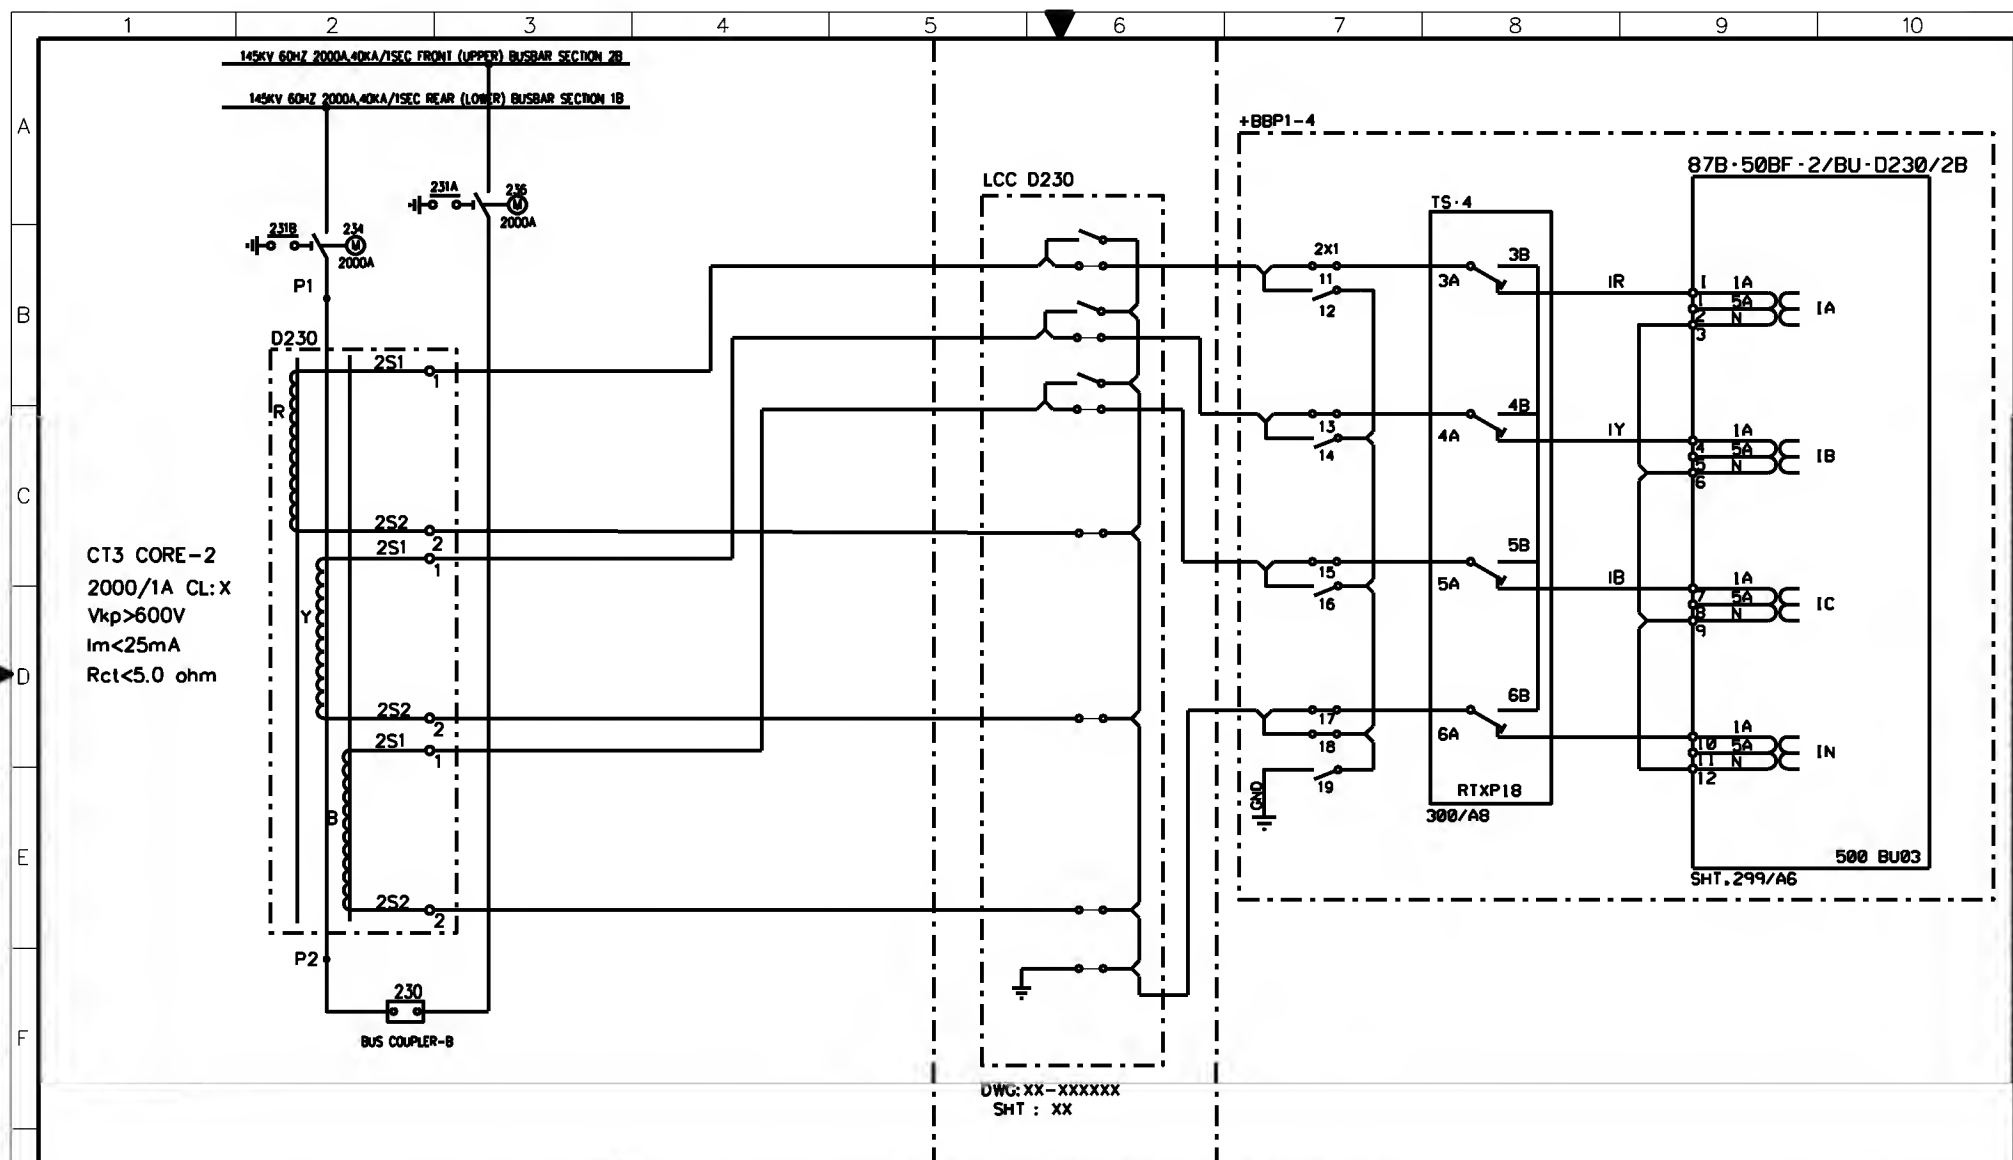


AS-BUILT BY _____ DATE _____		CONTRACT NO. 1113113/00	JOB ORDER NO. S-13656	CURRENT TRANSFORMER INPUTS -87B-50BF-1/BU-D230/2B		الشركة الوطنية لنقل الكهرباء		نقل الكهرباء	
01	13 49	FACTORY ASBUILT FOR APPROVAL	DRAWN BY RIZ CHECKED BY KVR	132KV BUSBAR PROT.N.MAIN-1 BU PANEL +BBP1-4		INDEX	PLANT NO.	DRAWING NUMBER	National Grid sa
00	13 05		DATE STARTED 28.01.2013 DATE COMPLETED _____	S/S 8709 - 132/13.8KV IN AL-KHARJ CITY		-	C421	CD-322997	
REV. NO.	DATE	DESCRIPTION	OPRG. DEPT. CTPD ENG. DEPT. AUT-PSAC	RIYADH SAUDI ARABIA		SHEET NO.		REV. NO.	
						SHT CONT.			
						224 231			01



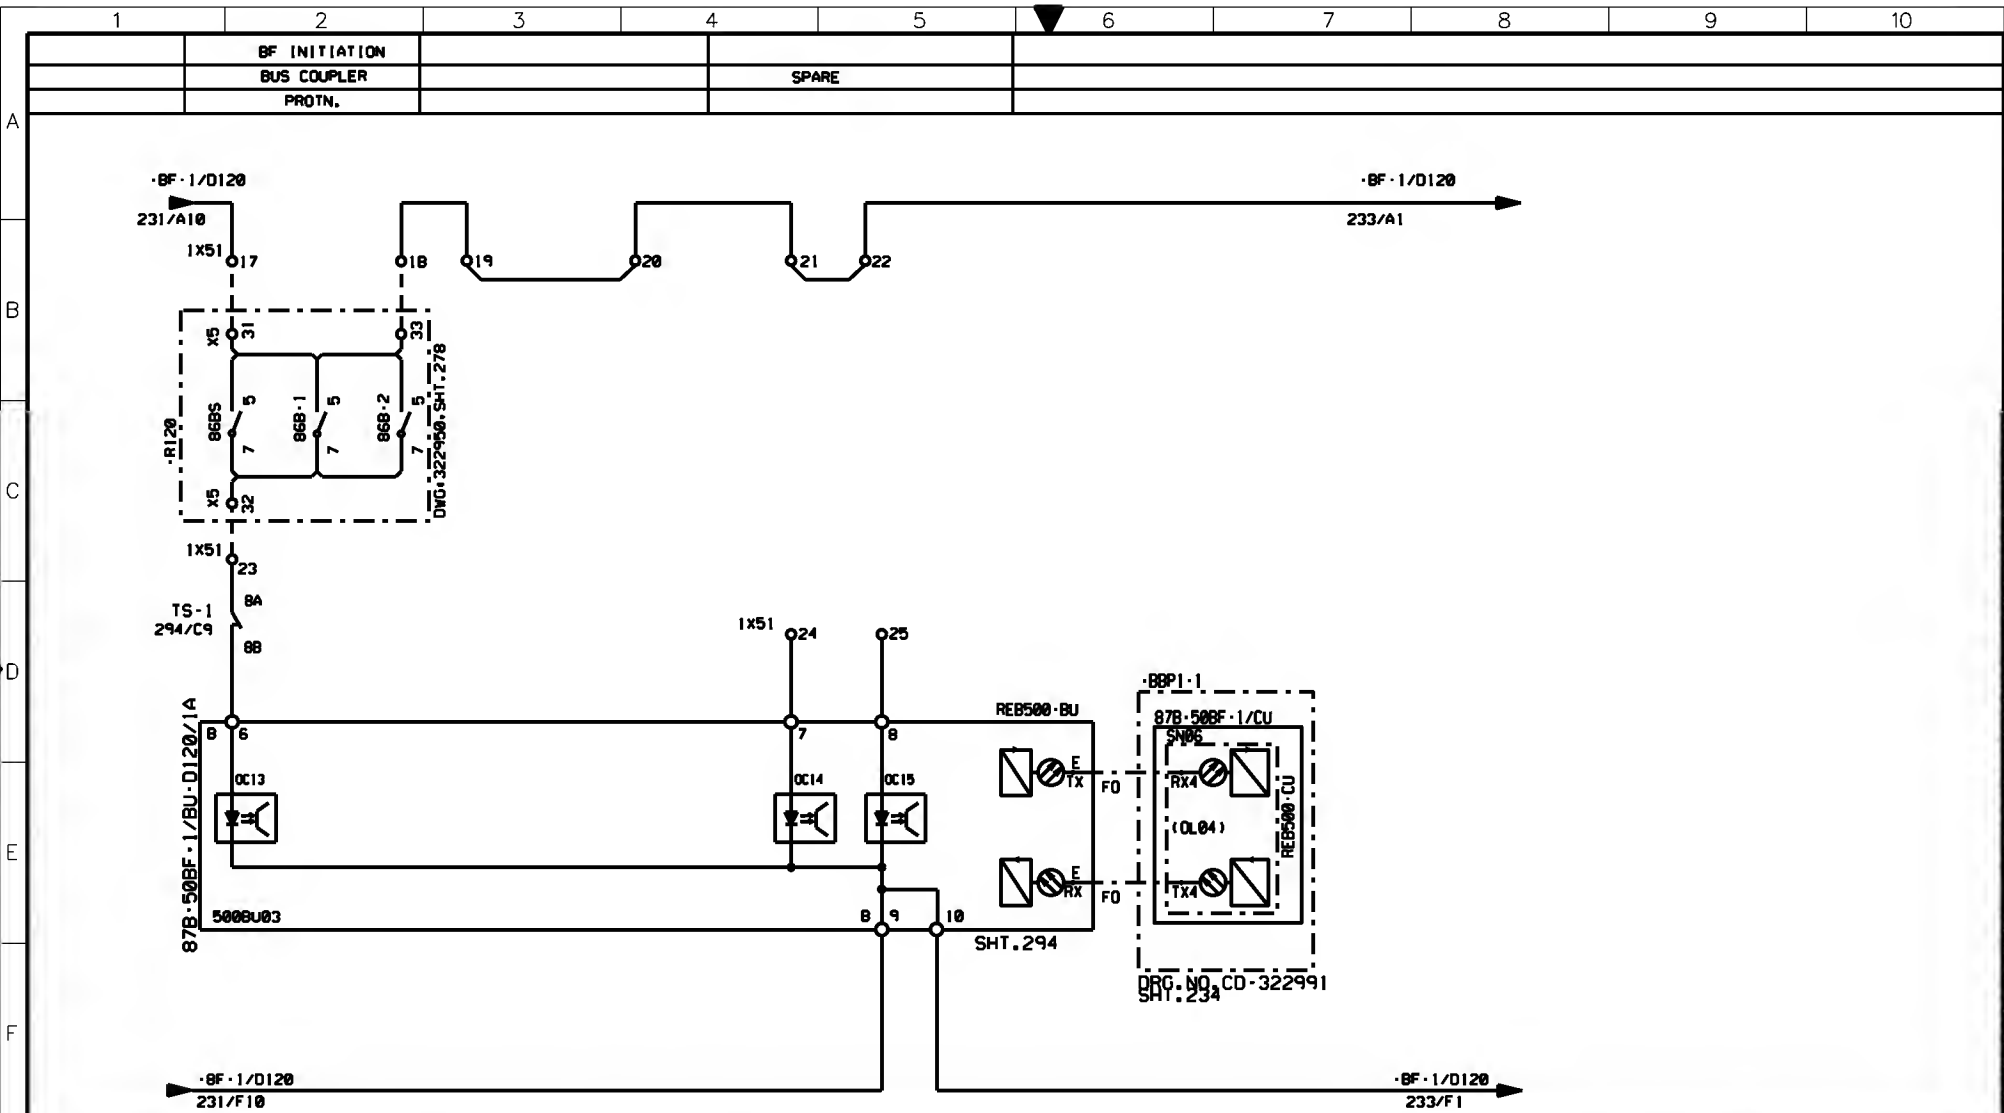


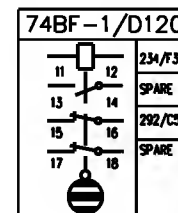
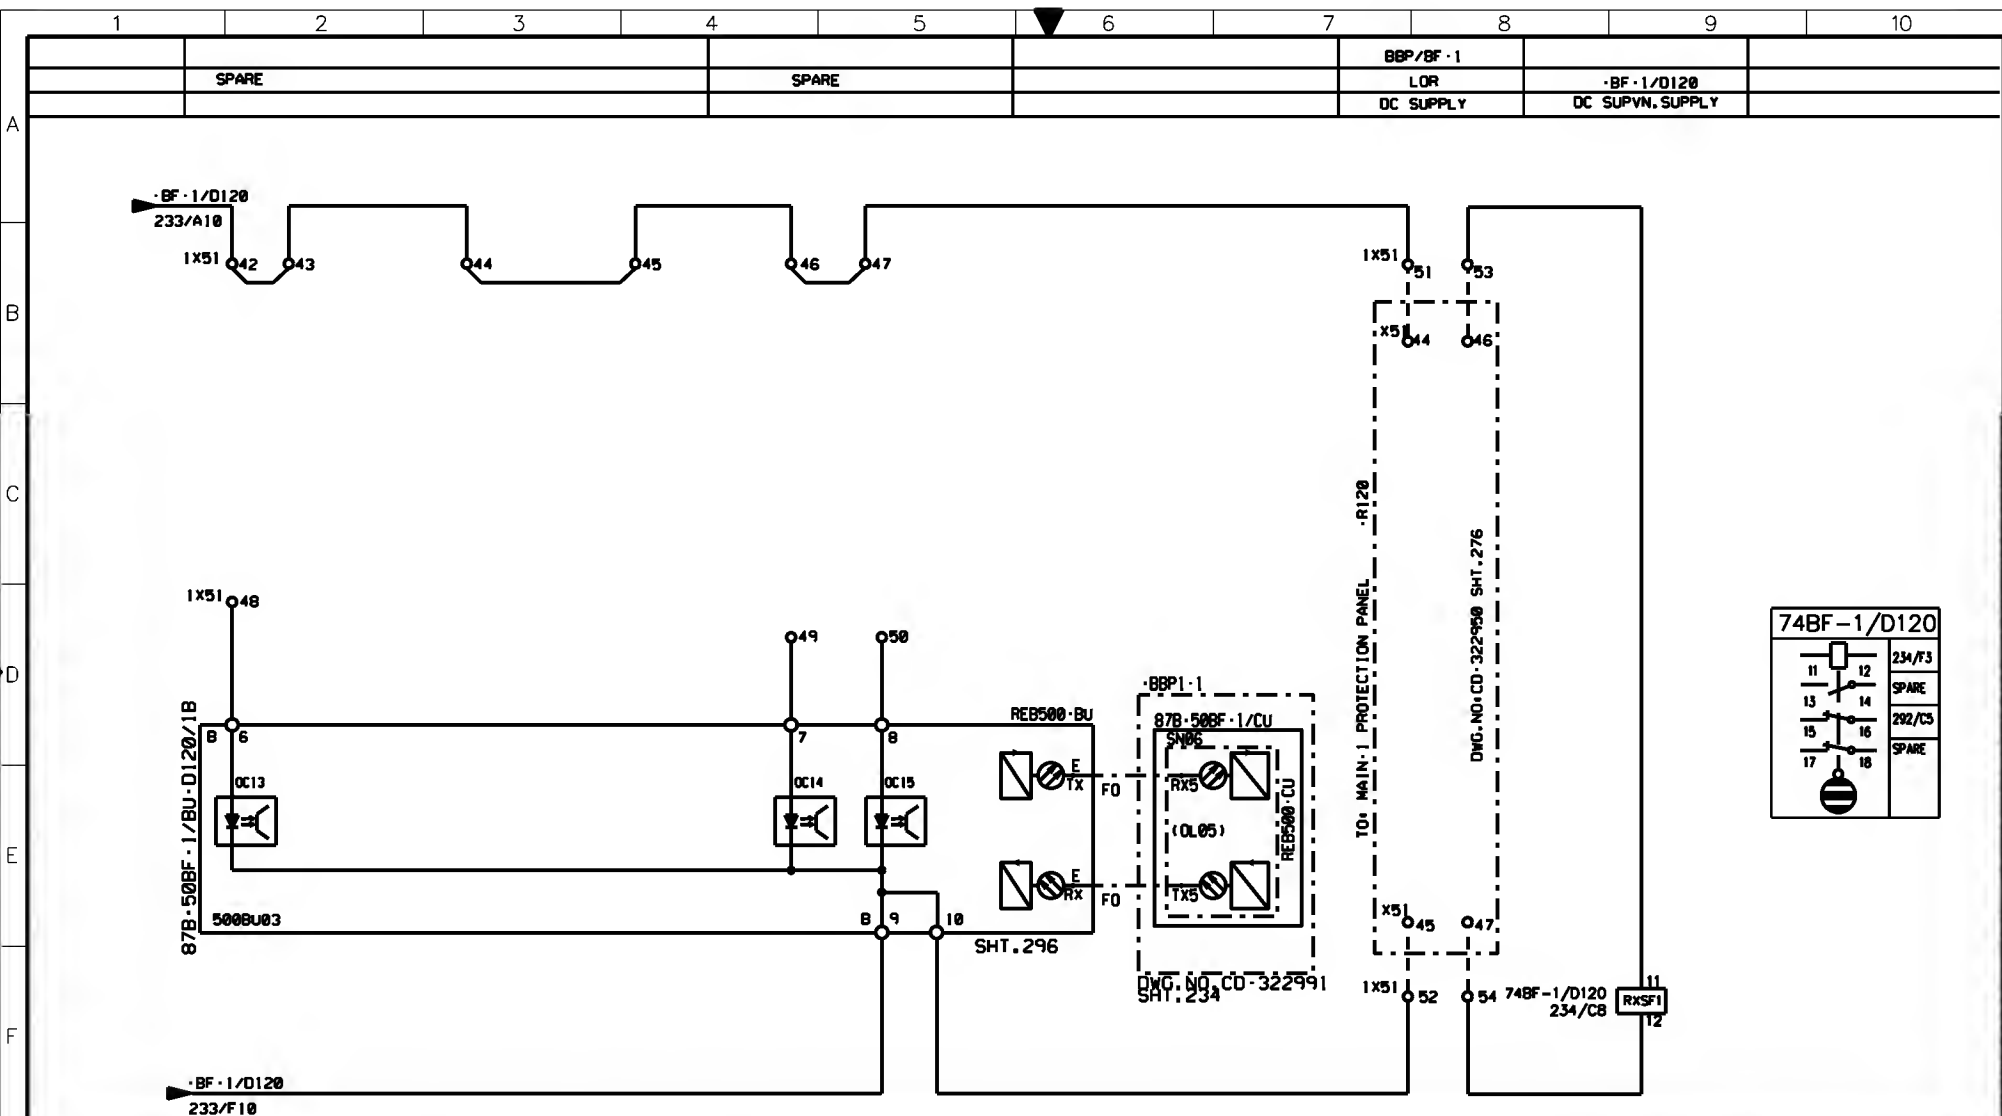
AS-BUILT BY _____ DATE _____		CONTRACT NO. 11131113/00	JOB ORDER NO. S-13656	87B-50BF-1/BU-D120/1A PROT.N.RELAY - BINARY INPUTS		الشركة الوطنية لنقل الكهرباء	
01	13 49	FACTORY ASBUILT FOR APPROVAL	DRAWN BY RIZ CHECKED BY KVR	132KV BUSBAR PROT.N.MAIN-1 BU PANEL +BBP1-4		National Grid sa	
00	13 05		DATE STARTED 28.01.2013 DATE COMPLETED _____	S/S 8709 - 132/13.8KV IN AL-KHARJ CITY		INDEX	PLANT NO.
REV. NO.	DATE	DESCRIPTION	OPRG. DEPT. CTPD ENG. DEPT. AUT-PSAC	RIYADH SAUDI ARABIA		-	C421
				DRAWING NUMBER CD-322997		SHEET NO.	REV. NO.
						SHT CONT.	01
						232	233



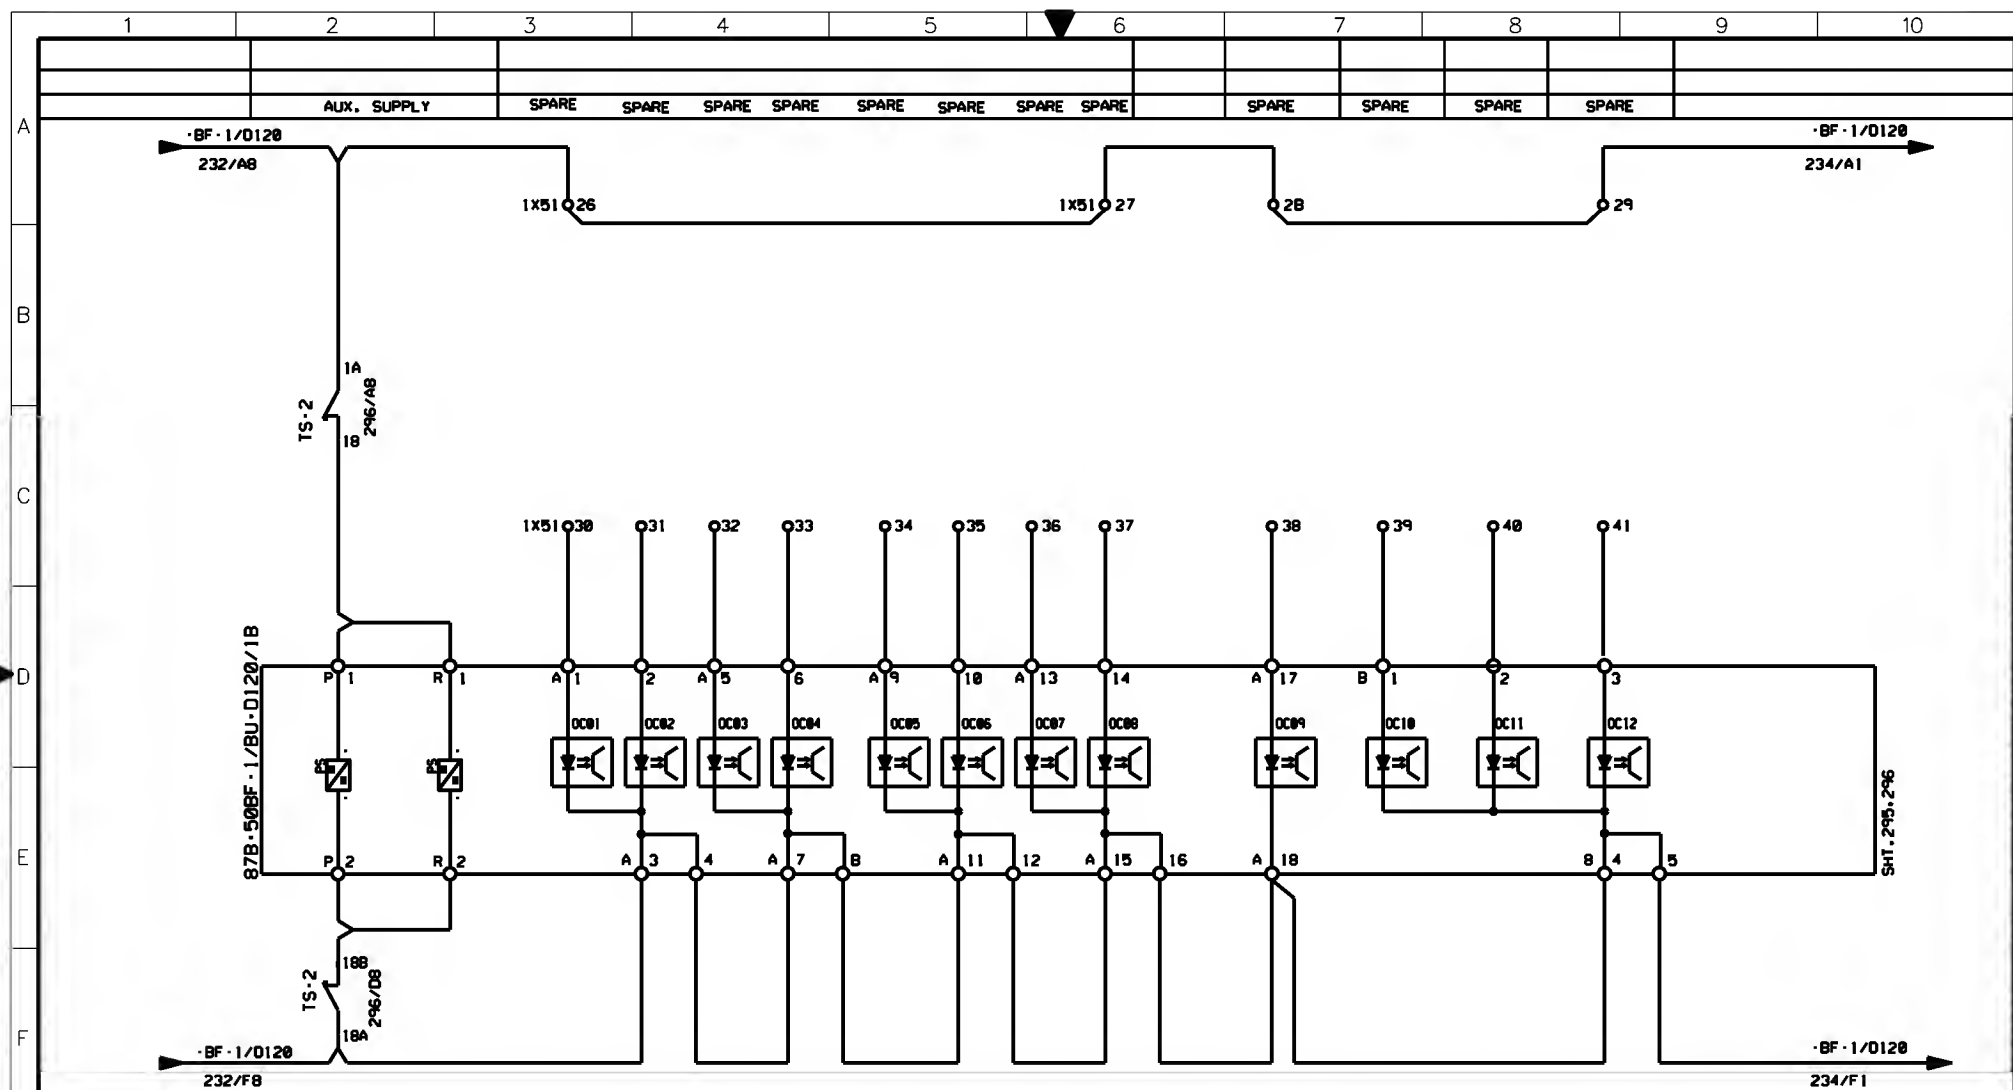


AS-BUILT BY _____ DATE _____			CONTRACT NO. 11131113/00		JOB ORDER NO. S-13656		87B-50BF-1/BU-D120/28 PROTN.RELAY - BINARY INPUTS		<div>نقل الكهرباء</div> <div>الشركة الوطنية لنقل الكهرباء</div> <div>National Grid sa</div>				
			DRAWN BY RIZ		CHECKED BY KVR		132KV BUSBAR PROTN.MAIN-1 BU PANEL +BBP1-4						
01 13 49			FACTORY ASBUILT		DATE STARTED 28.01.2013		S/S 8709 - 132/13.8KV IN AL-KHARJ CITY						
00 13 05			FOR APPROVAL		DATE COMPLETED _____		RIYADH SAUDI ARABIA						
REV. NO. _____ DATE _____			DESCRIPTION _____		OPRG. DEPT. CTPD		ENG. DEPT. AUT-PSAC						


THIS DRAWING AND THE INFORMATION CONTAINED HEREIN ARE THE SOLE PROPERTY OF NATIONAL GRID SA. NO REPRODUCTION OR TRANSMISSION IN ANY FORM OR BY ANY MEANS, WITHOUT THE WRITTEN CONSENT OF NATIONAL GRID SA, IS PERMITTED.




AS-BUILT BY _____ DATE _____		CONTRACT NO. 11131113/00	JOB ORDER NO. S-13656	87B-50BF-1/BU-D120/28 PROTN.RELAY - BINARY INPUTS		الشركة الوطنية لنقل الكهرباء	
01	13 49	FACTORY ASBUILT FOR APPROVAL	DRAWN BY RIZ CHECKED BY KVR	132KV BUSBAR PROTN.MAIN-1 BU PANEL +BBP1-4		National Grid sa	
00	13 05		DATE STARTED 28.01.2013 DATE COMPLETED _____	S/S 8709 - 132/13.8KV IN AL-KHARJ CITY		INDEX	PLANT NO.
REV. NO.	DATE	DESCRIPTION	OPRG. DEPT. CTPD ENG. DEPT. AUT-PSAC	RIYADH SAUDI ARABIA		-	C421
				DRAWING NUMBER		CD-322997	
				SHEET NO.		234	
				CONT.		235	
				REV. NO.		01	

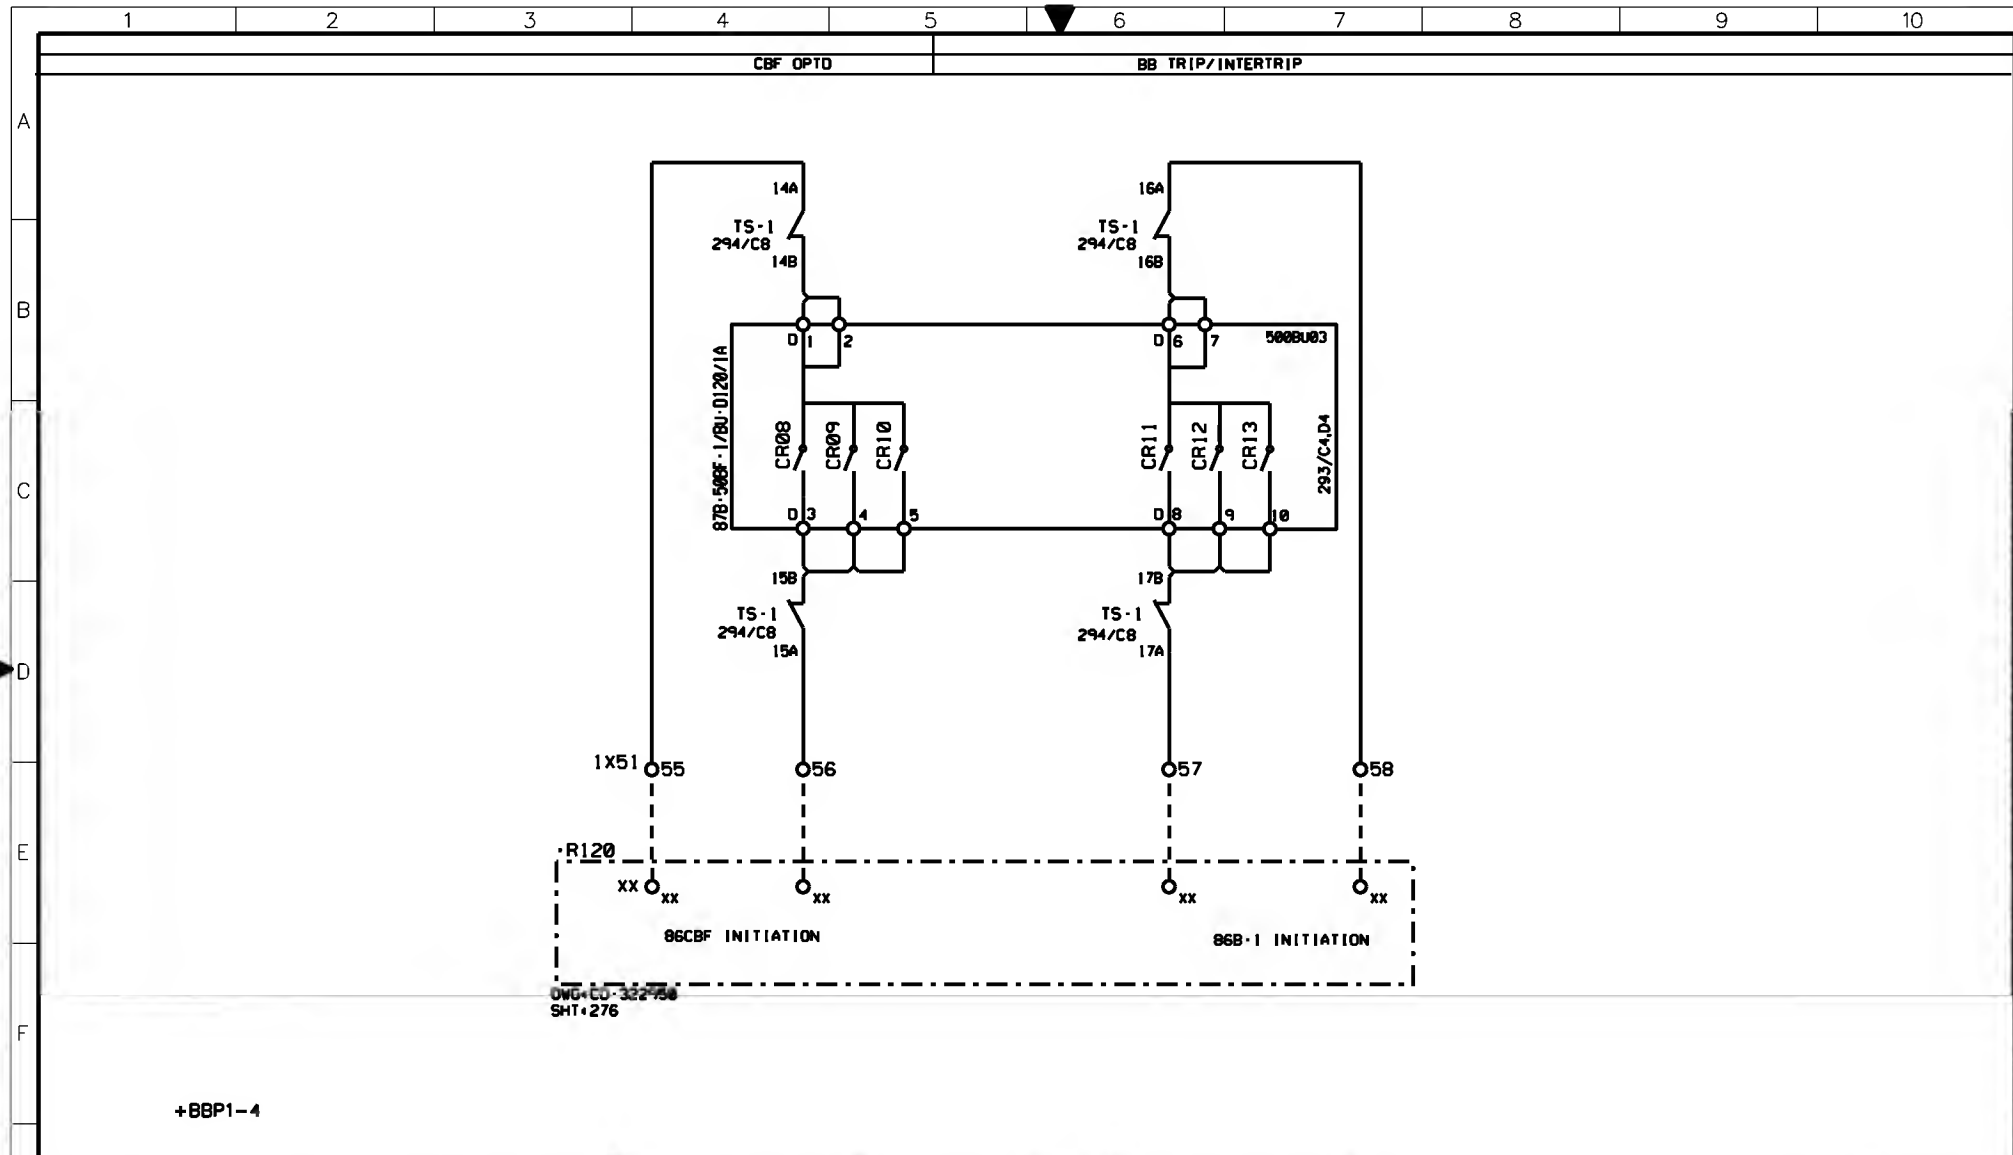


AS-BUILT BY _____ DATE _____			CONTRACT NO. 1113113/00		JOB ORDER NO. S-13656		CBF & BUSBAR PROTN-1 TRIP RELAY CIRCUIT			الشركة الوطنية لنقل الكهرباء		
01 13 49 FACTORY ASBUILT			DRAWN BY RIZ		CHECKED BY KVR		132KV BUSBAR PROTN.MAIN-1 BU PANEL +BBP1-4			National Grid sa		
00 13 05 FOR APPROVAL			DATE STARTED 28.01.2013		DATE COMPLETED _____		S/S 8709 - 132/13.8KV IN AL-KHARJ CITY			INDEX PLANT NO. DRAWING NUMBER SHEET NO. REV. NO.		
REV. NO. DATE DESCRIPTION			OPRG. DEPT. CTPD		ENG. DEPT. AUT-PSAC		RIYADH SAUDI ARABIA			- C421 CD-322997 235 236 01		

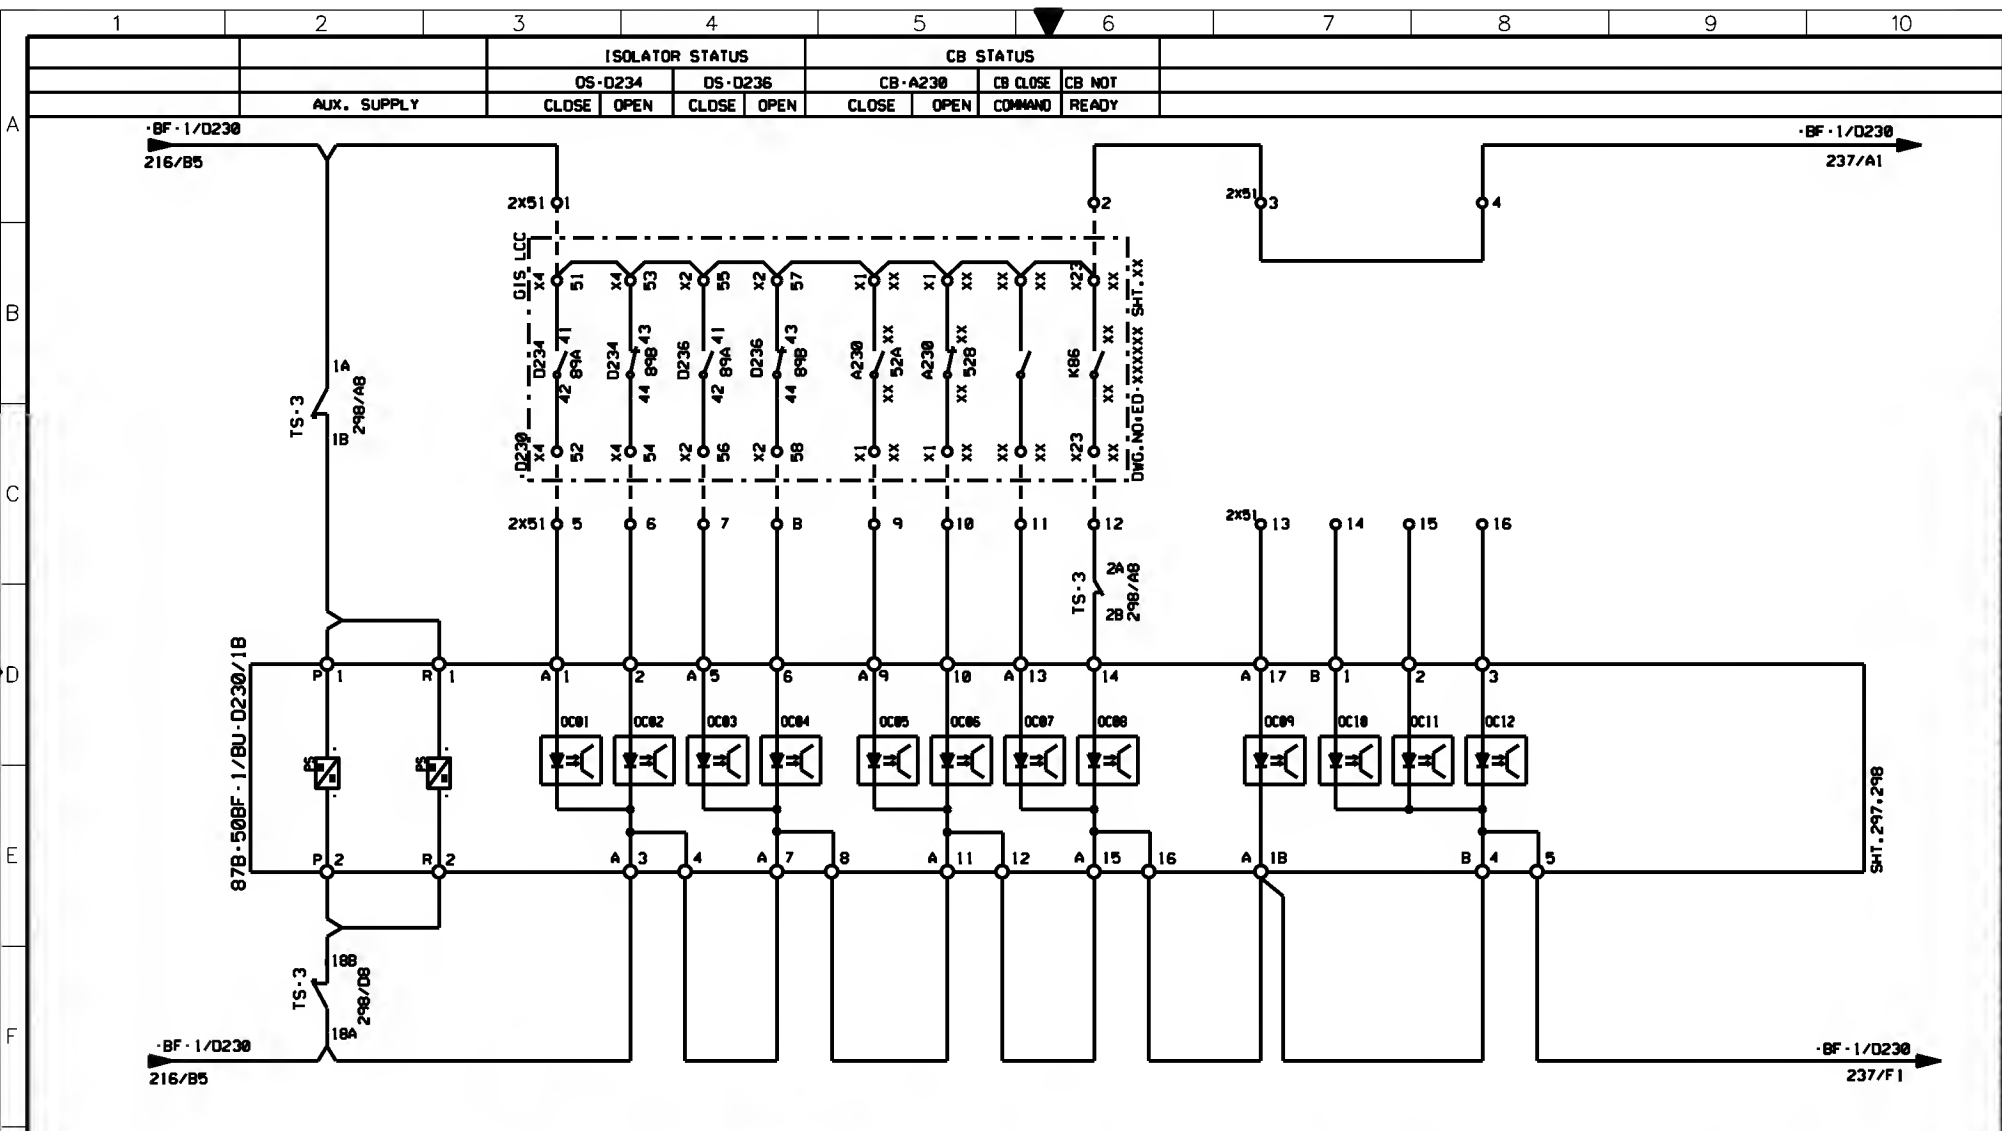

AS-BUILT BY _____ DATE _____		CONTRACT NO. 11131113/00	JOB ORDER NO. S-13656	87B-508F-1/BU-D230/1B PROTN. RELAY - BINARY INPUTS		الشركة الوطنية لنقل الكهرباء	
01	13 49	FACTORY ASBUILT FOR APPROVAL	DRAWN BY RIZ CHECKED BY KVR	132KV BUSBAR PROTN. MAIN-1 BU PANEL +BBP1-4		National Grid sa	
00	13 05		DATE STARTED 28.01.2013 DATE COMPLETED _____	S/S 8709 - 132/13.8KV IN AL-KHARJ CITY		INDEX	PLANT NO.
REV. NO.	DATE	DESCRIPTION	OPRG. DEPT. CTPD ENG. DEPT. AUT-PSAC	RIYADH SAUDI ARABIA		-	C421
				DRAWING NUMBER		CD-322997	
				SHEET NO.		236/237	
				REV. NO.		01	


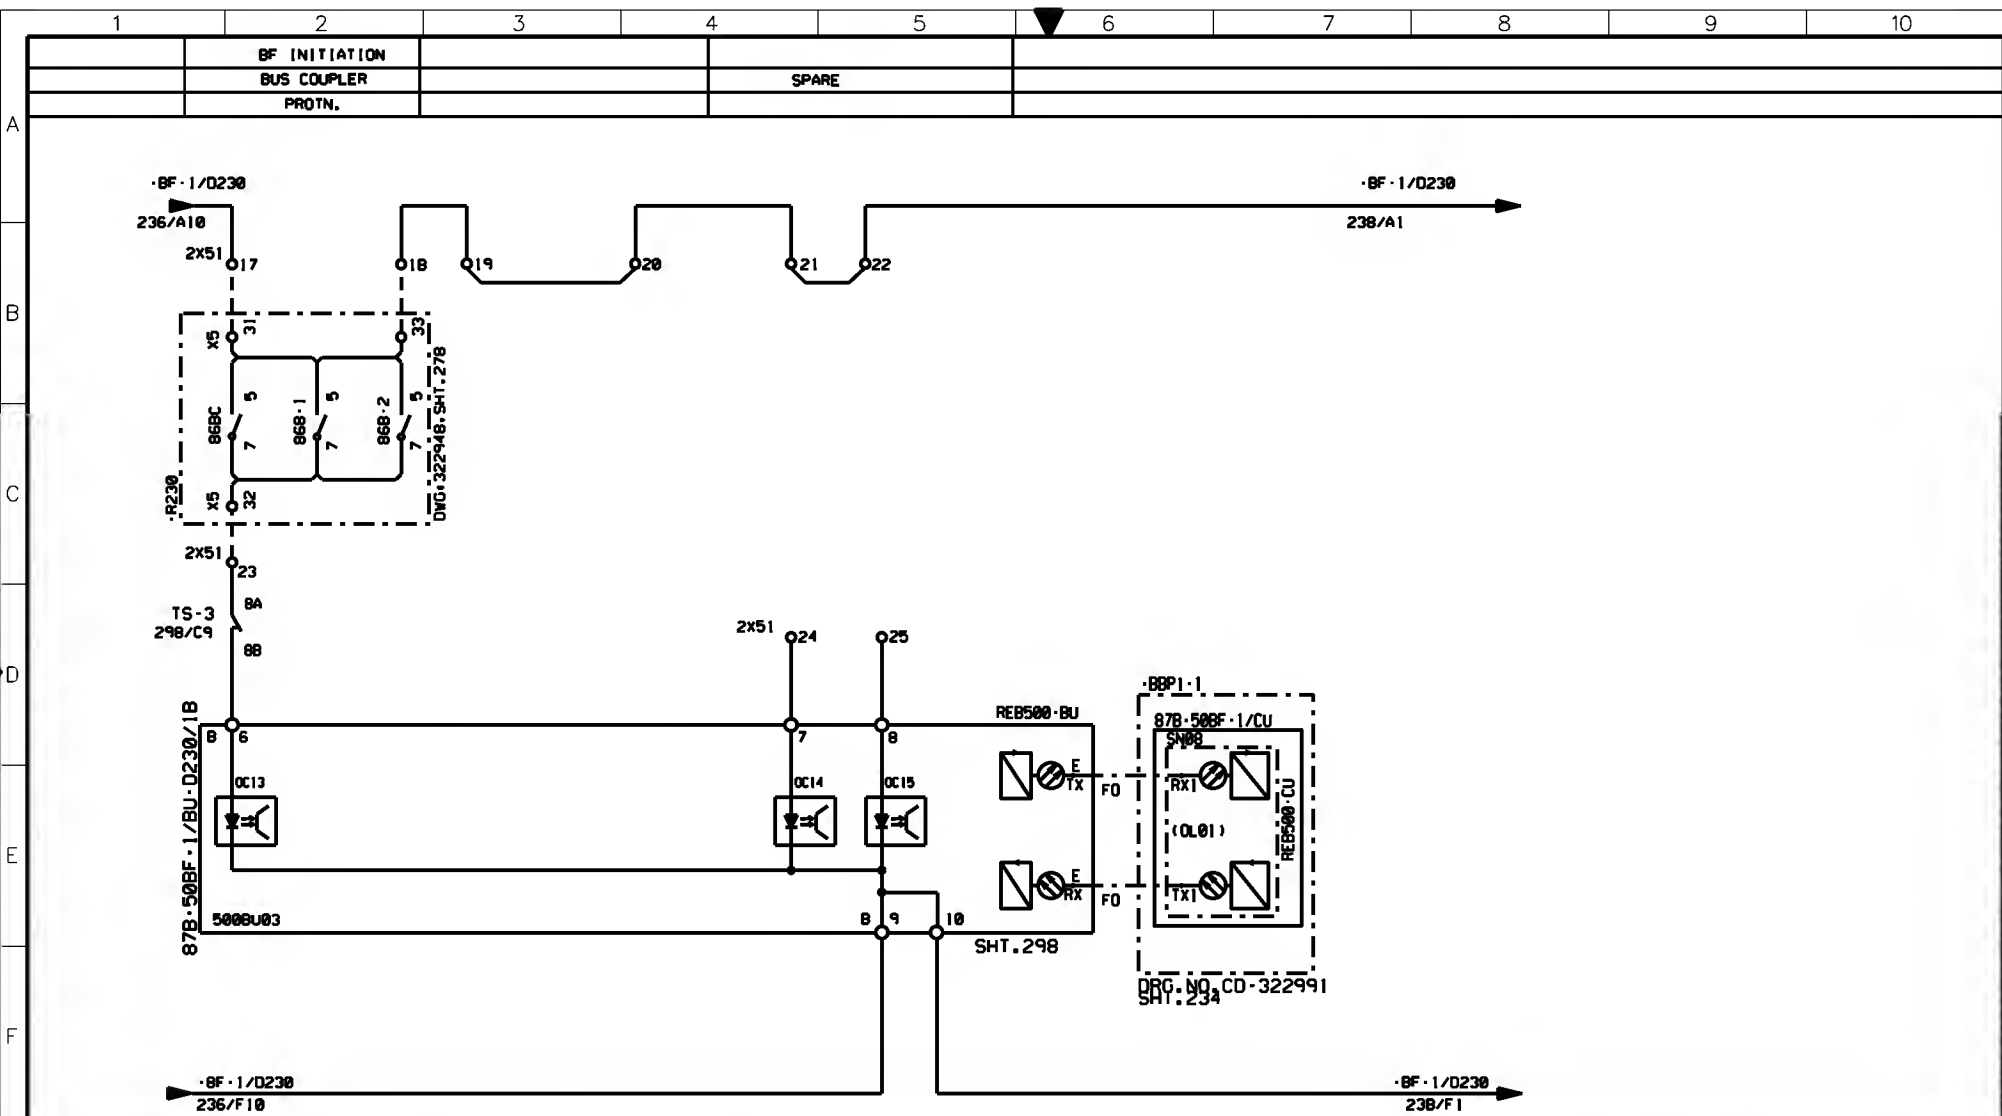


AS-BUILT BY _____ DATE _____		CONTRACT NO. 11131113/00	JOB ORDER NO. S-13656	87B-50BF-1/BU-D230/1B PROTN.RELAY - BINARY INPUTS		الشركة الوطنية لنقل الكهرباء		نقل الكهرباء	
01	13 49	FACTORY ASBUILT FOR APPROVAL	DRAWN BY RIZ CHECKED BY KVR	132KV BUSBAR PROTN.MAIN-1 BU PANEL +BBP1-4		INDEX	PLANT NO.	DRAWING NUMBER	National Grid sa
00	13 05		DATE STARTED 28.01.2013 DATE COMPLETED _____	S/S 8709 - 132/13.8KV IN AL-KHARJ CITY		-	C421	CD-322997	
REV. NO.	DATE	DESCRIPTION	OPRG. DEPT. CTPD ENG. DEPT. AUT-PSAC	RIYADH SAUDI ARABIA		SHEET NO.		REV. NO.	
						SHT CONT.			
						237 238			01

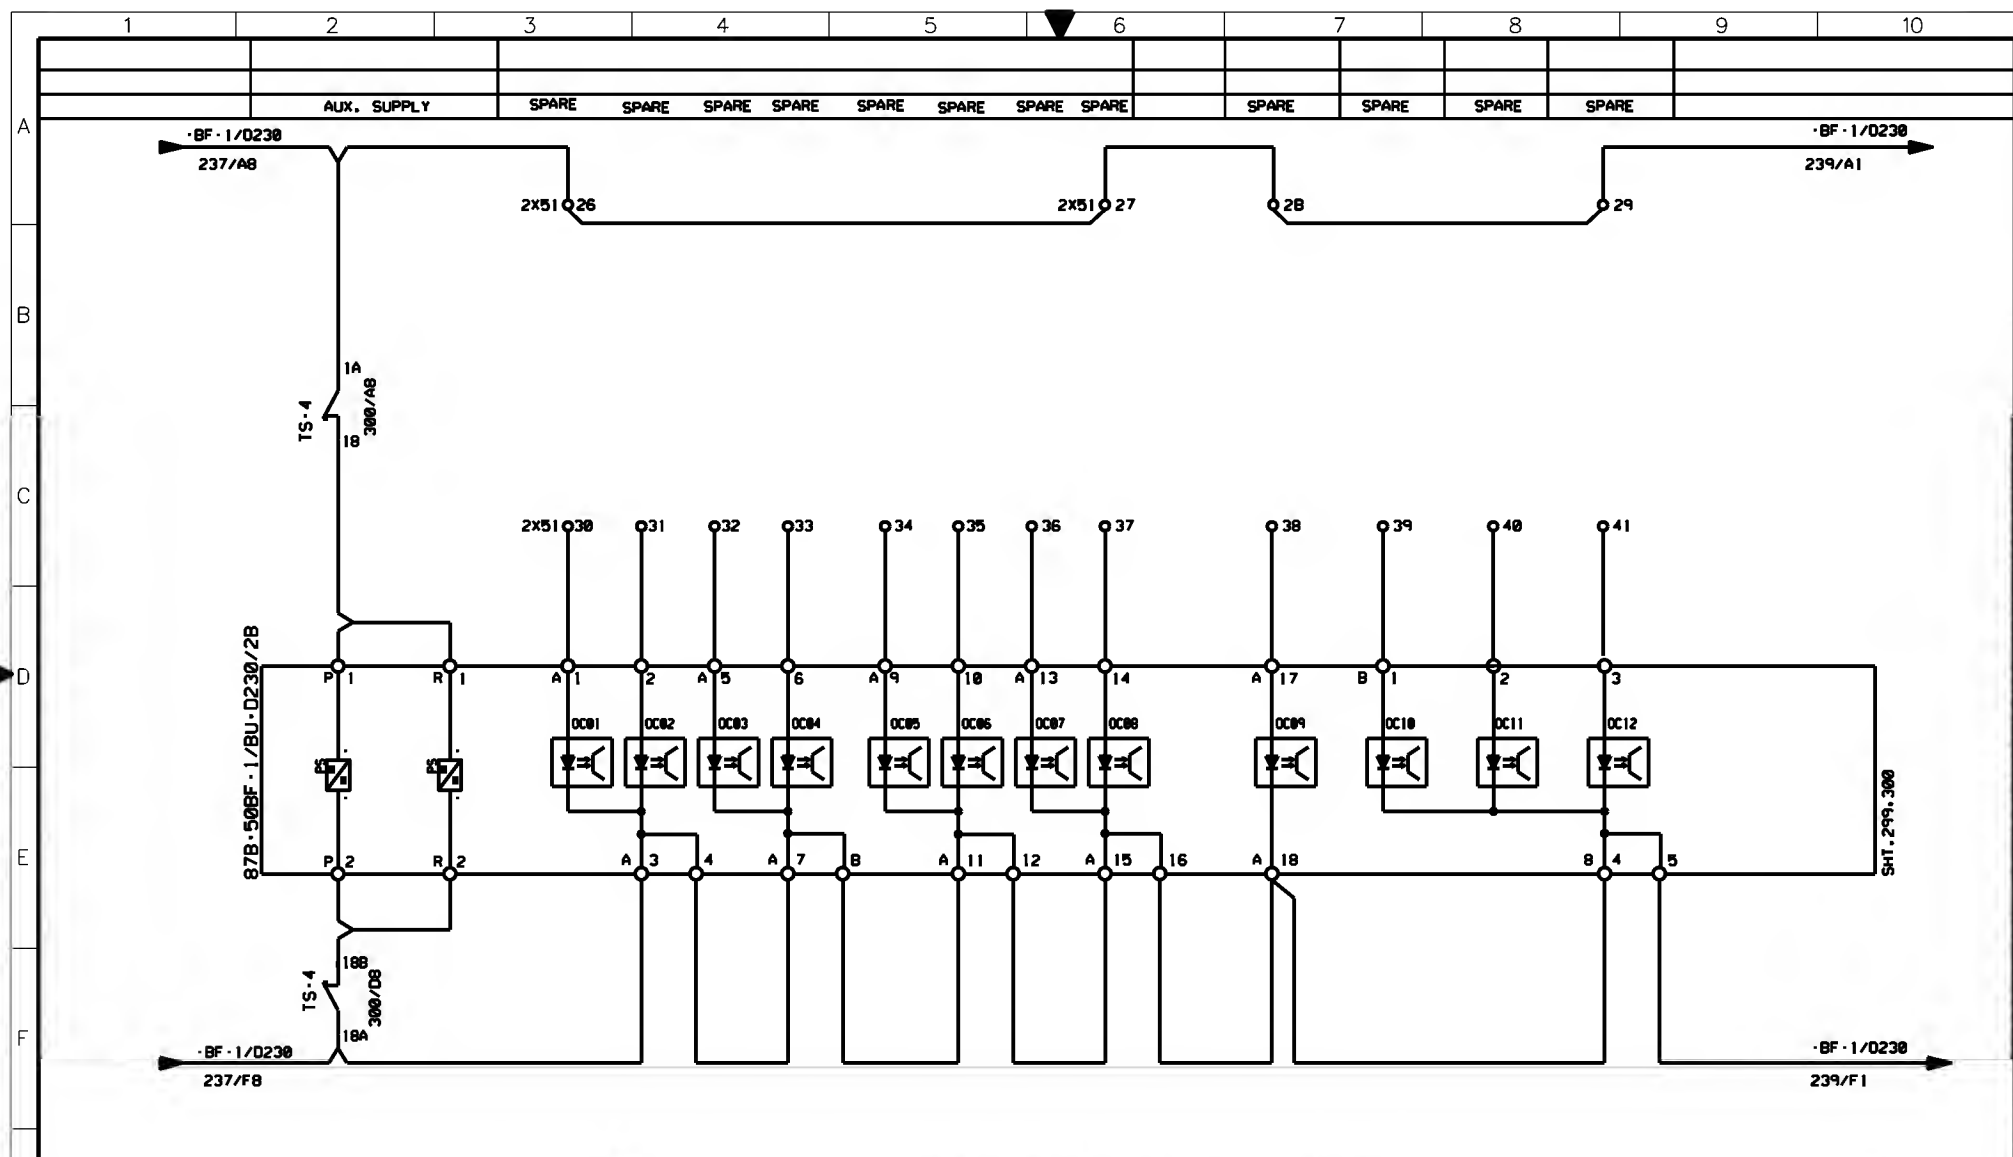


AS-BUILT BY _____ DATE _____		CONTRACT NO. 11131113/00	JOB ORDER NO. S-13656	87B-50BF-1/BU-D230/28 PROT.N.RELAY - BINARY INPUTS		الشركة الوطنية لنقل الكهرباء		نقل الكهرباء	
01	13 49	FACTORY ASBUILT FOR APPROVAL	DRAWN BY RIZ CHECKED BY KVR	132KV BUSBAR PROTN.MAIN-1 BU PANEL +BBP1-4		INDEX	PLANT NO.	DRAWING NUMBER	SHEET NO.
00	13 05		DATE STARTED 28.01.2013 DATE COMPLETED _____	S/S 8709 - 132/13.8KV IN AL-KHARJ CITY					
REV. NO.	DATE	DESCRIPTION	OPRG. DEPT. CTPD ENG. DEPT. AUT-PSAC	RIYADH SAUDI ARABIA		-	C421	CD-322997	238 239
								SHT CONT.	
								01	

THIS DRAWING AND THE INFORMATION CONTAINED HEREIN ARE THE SOLE PROPERTY OF NATIONAL GRID SA. NO REPRODUCTION OR TRANSMISSION IN ANY FORM OR BY ANY MEANS, WITHOUT THE WRITTEN CONSENT OF NATIONAL GRID SA, IS PERMITTED.

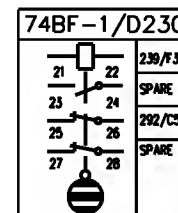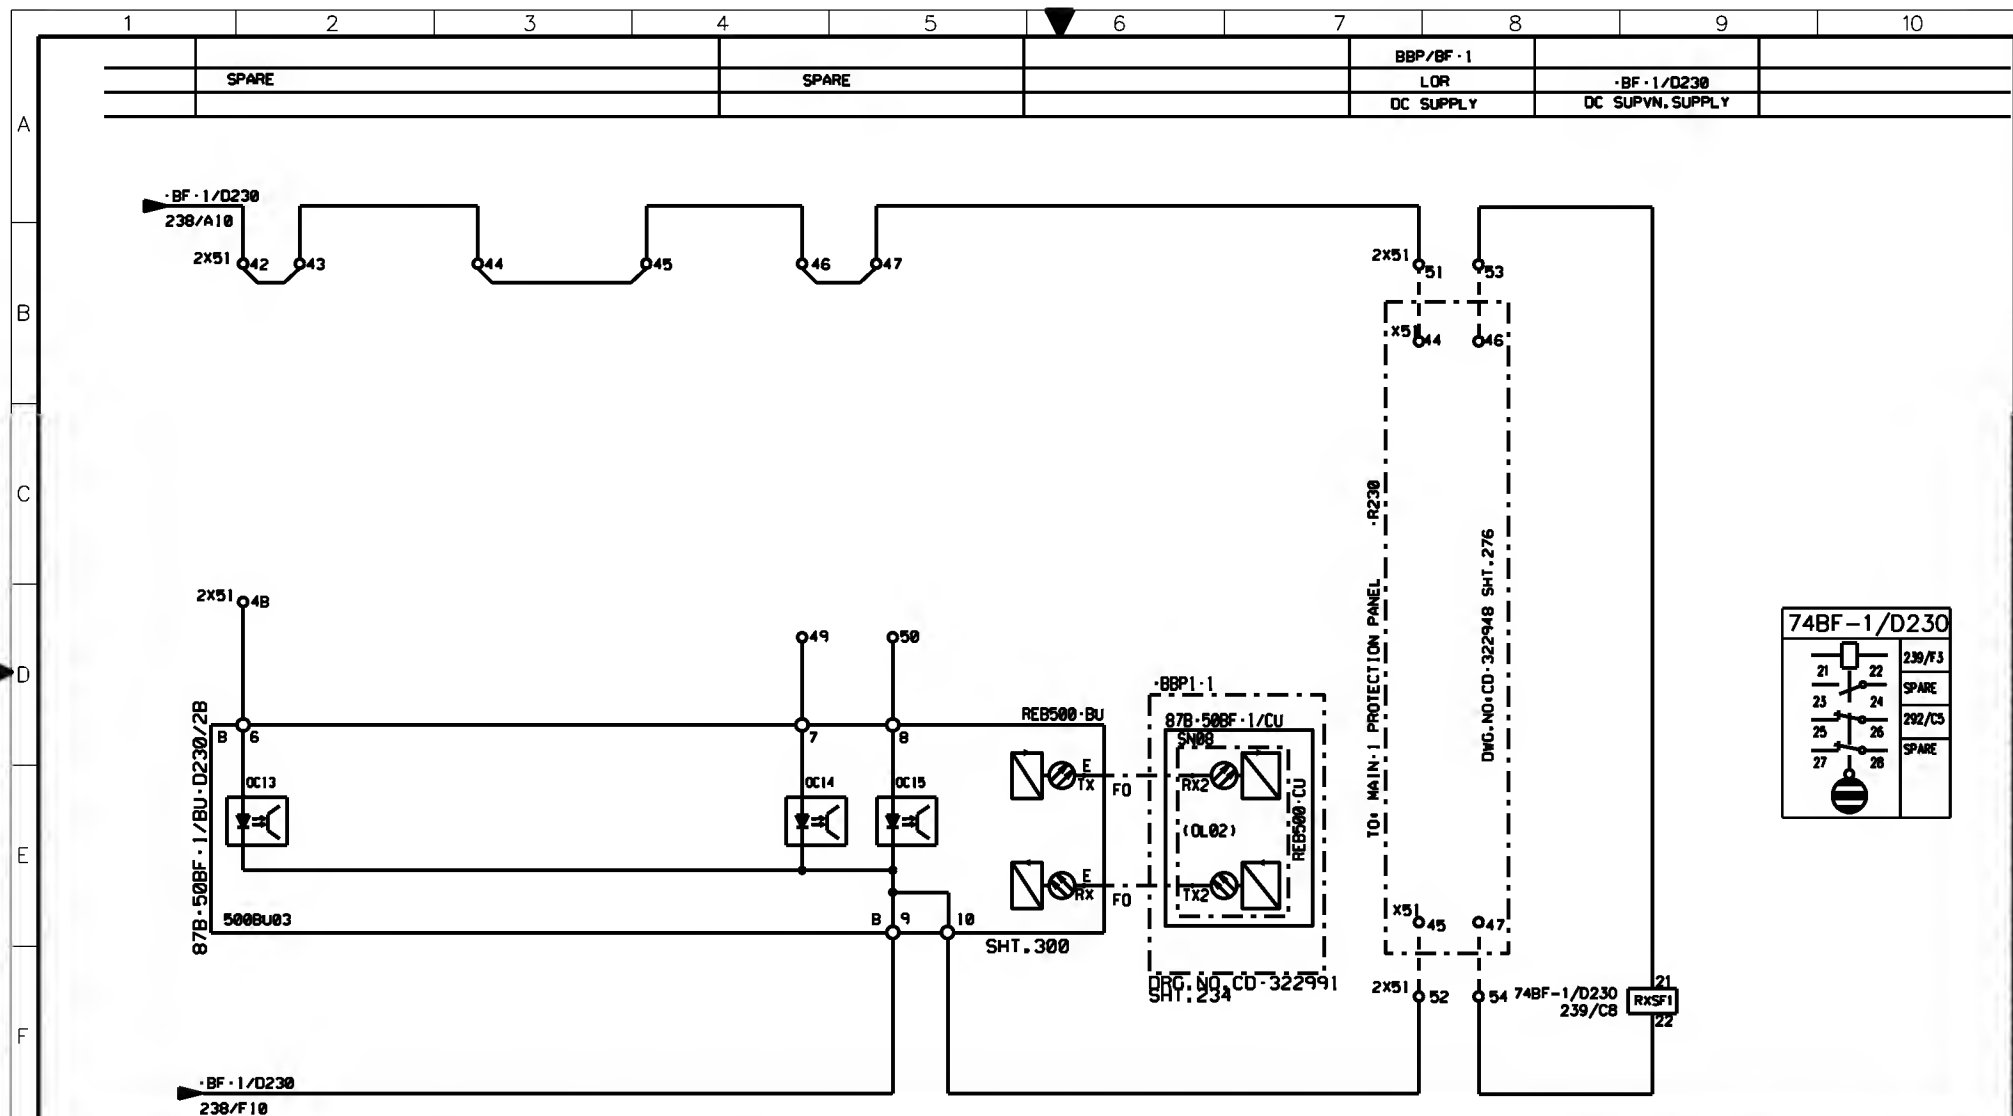


AS-BUILT BY _____ DATE _____			CONTRACT NO. 1113113/00		JOB ORDER NO. S-13656		87B+50BF-1/BU-D230/28 PROT.N. RELAY - BINARY INPUTS		نقل الكهرباء الشركة الوطنية لنقل الكهرباء National Grid sa				
			DRAWN BY: RIZ		CHECKED BY: KVR		132KV BUSBAR PROT.N.MAIN-1 BU PANEL +BBP1-4						
01 13 49			FACTORY ASBUILT		DATE STARTED: 28.01.2013		S/S 8709 - 132/13.8KV IN AL-KHARJ CITY						
00 13 05			FOR APPROVAL		DATE COMPLETED: _____		RIYADH SAUDI ARABIA						
REV. NO.			DESCRIPTION		OPRG. DEPT. CTPD		ENG. DEPT. AUT-PSAC						

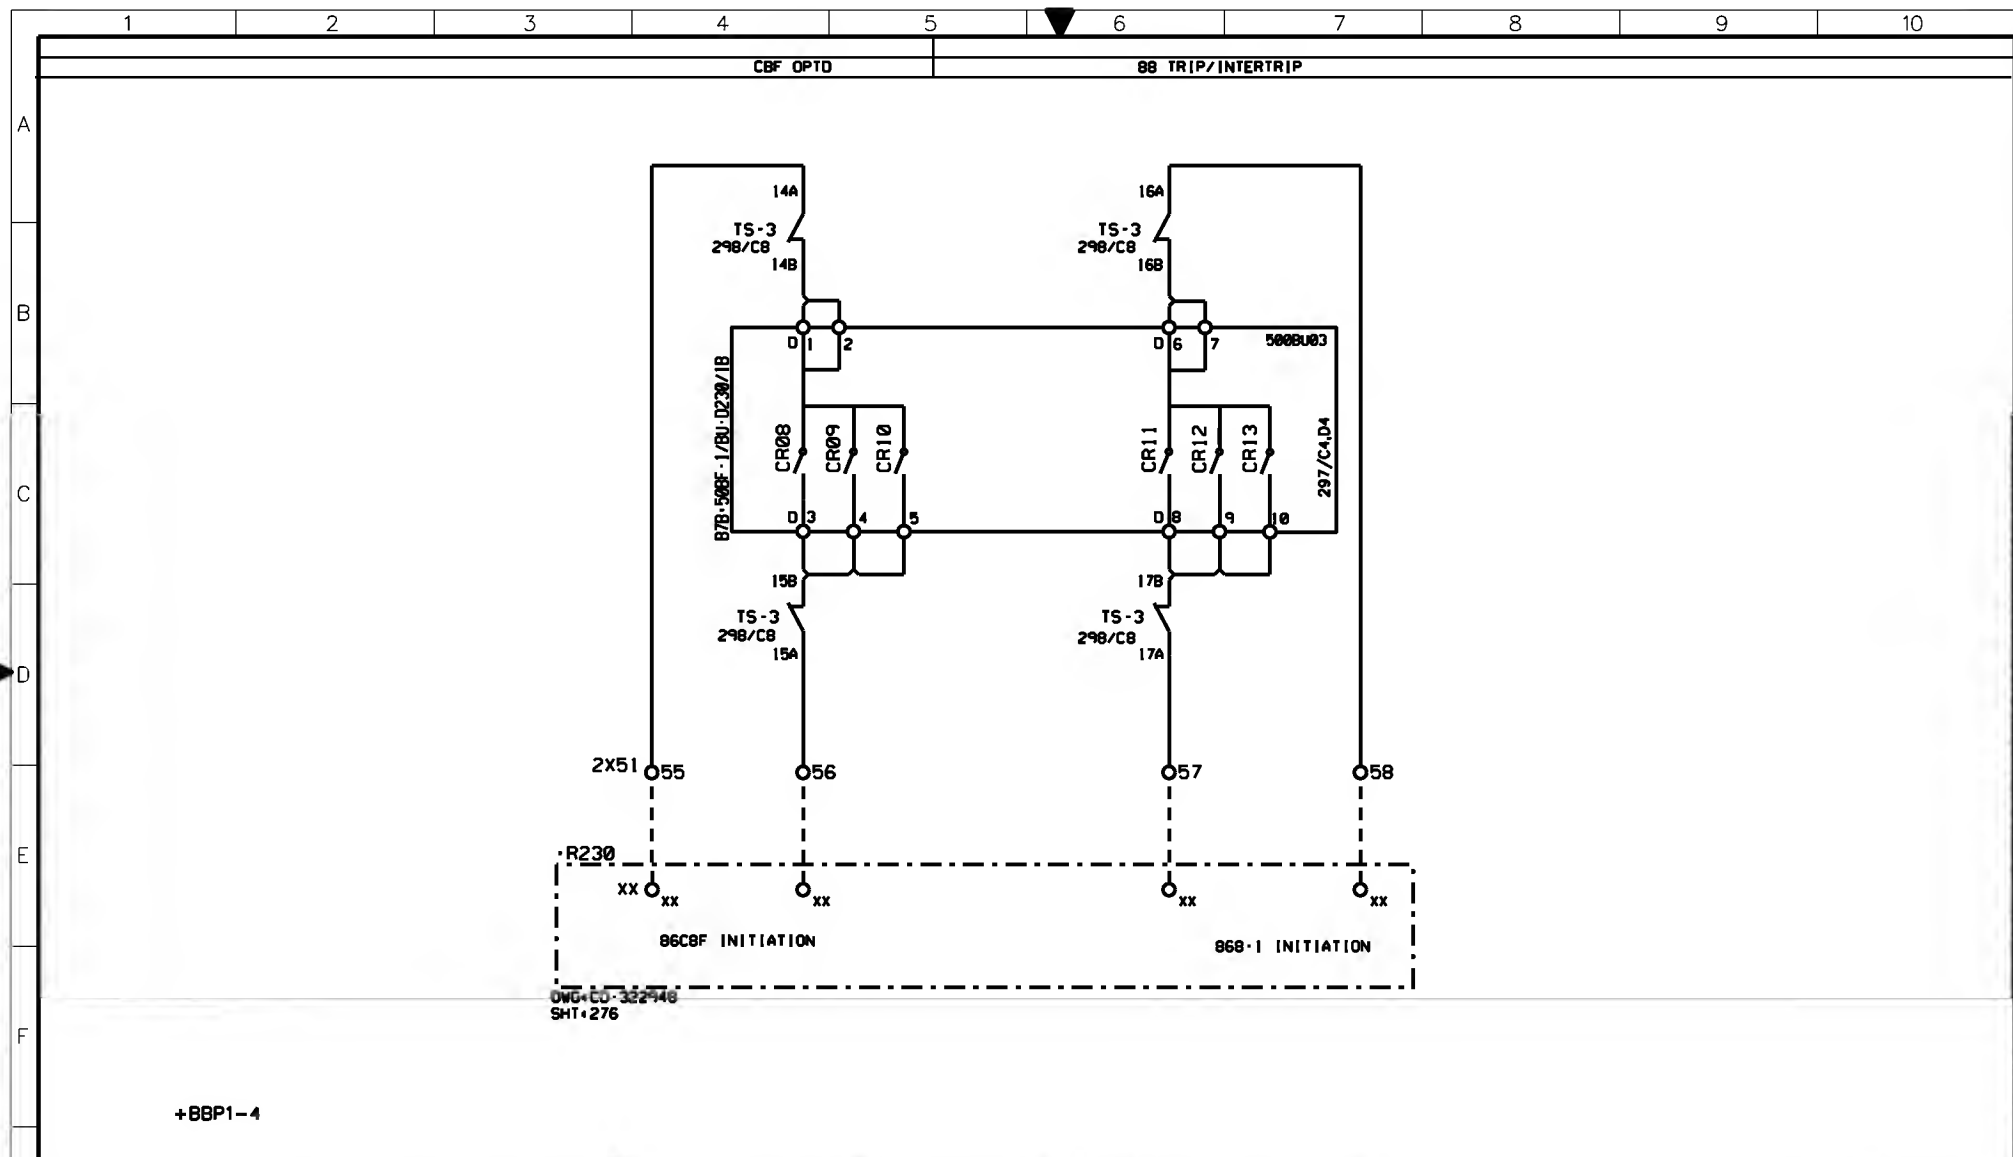


AS-BUILT BY _____ DATE _____			CONTRACT NO. 11131113/00		JOB ORDER NO. S-13656		CBF-1 & BUSBAR PROTN-1 TRIP RELAY CIRCUIT			<div style="display: flex; align-items: center;"> <div style="margin-right: 10px;">الشركة الوطنية لنقل الكهرباء</div> <div style="text-align: center;">   National Grid sa </div> </div>					
01	3 49	FACTORY ASBUILT	DRAWN BY RIZ		CHECKED BY KVR		132KV BUSBAR PROTN.MAIN-1 BU PANEL +88P1-4								
00	13 05	FOR APPROVAL	DATE STARTED 28.01.2013		DATE COMPLETED _____		S/S 8709 - 132/13.8KV IN AL-KHARJ CITY								
REV. NO.	DATE	DESCRIPTION	OPRG. DEPT. CTPD		ENG. DEPT. AUT-PSAC		RIYADH SAUDI ARABIA			INDEX	PLANT NO.	DRAWING NUMBER	SHEET NO.	REV. NO.	
										-	C421	CD-322997	240 292	01	




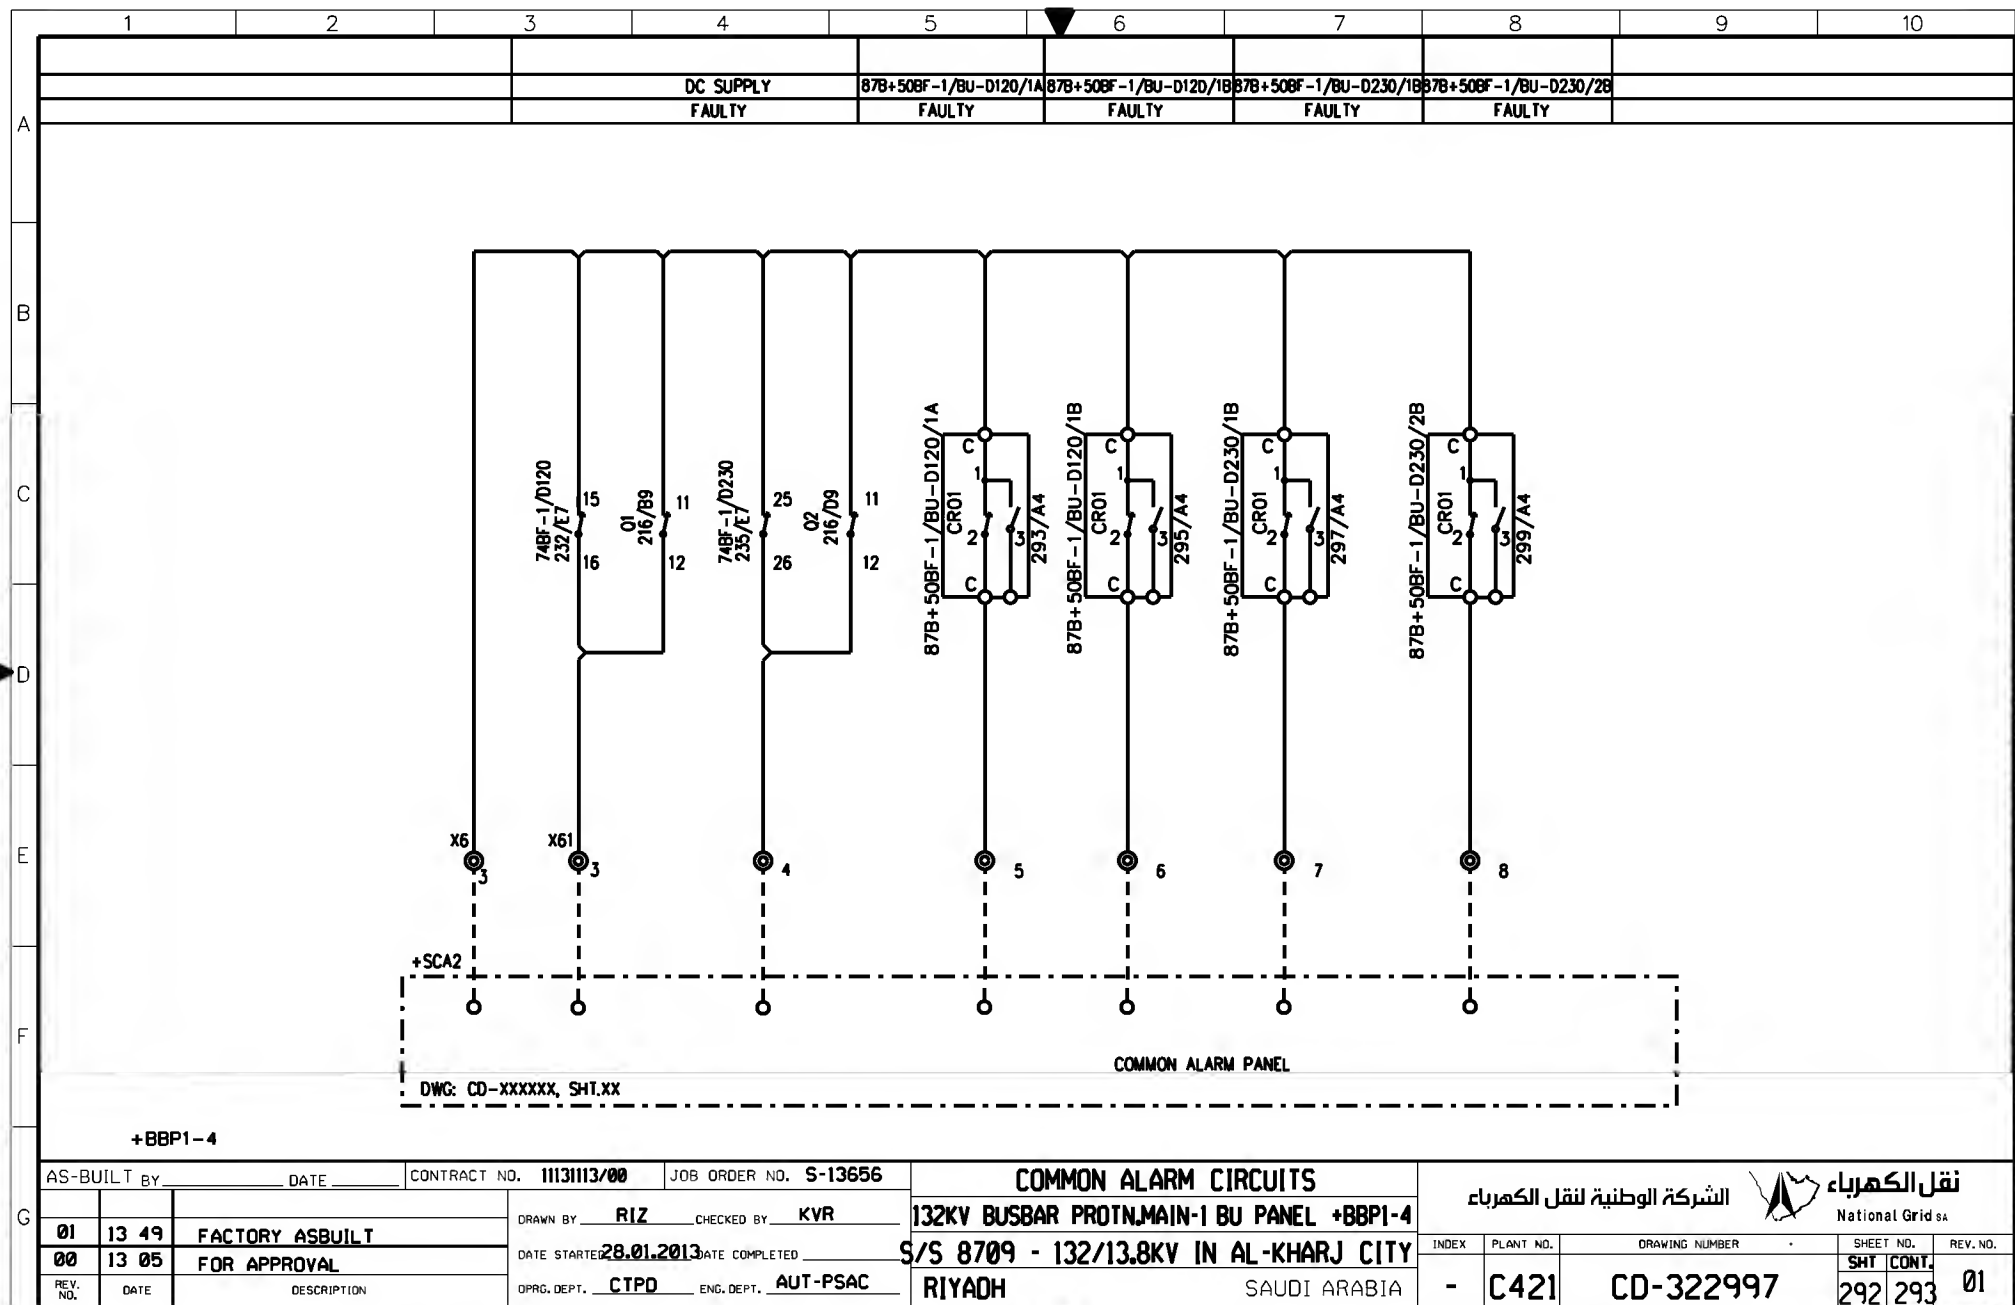

AS-BUILT BY _____ DATE _____			CONTRACT NO. 11131113/00		JOB ORDER NO. S-13656		COMMON ALARM CIRCUITS			الشركة الوطنية لنقل الكهرباء		
DRAWN BY RIZ CHECKED BY KVR			DATE STARTED 28.01.2013		DATE COMPLETED _____		132KV BUSBAR PROTN.MAIN-1 BU PANEL +BBP1-4			National Grid sa		
DESCRIPTION			OPRG. DEPT. CTPD		ENG. DEPT. AUT-PSAC		S/S 8709 - 132/13.8KV IN AL-KHARJ CITY			INDEX PLANT NO. DRAWING NUMBER SHEET NO. REV. NO.		
FACTORY ASBUILT			RIZ		KVR		SAUDI ARABIA			- C421 CD-322997 292 293 01		
FOR APPROVAL			DATE STARTED 28.01.2013		DATE COMPLETED _____		Riyadh			SHT CONT.		
REV. NO. DATE			CTPD		AUT-PSAC		SAUDI ARABIA			292 293 01		

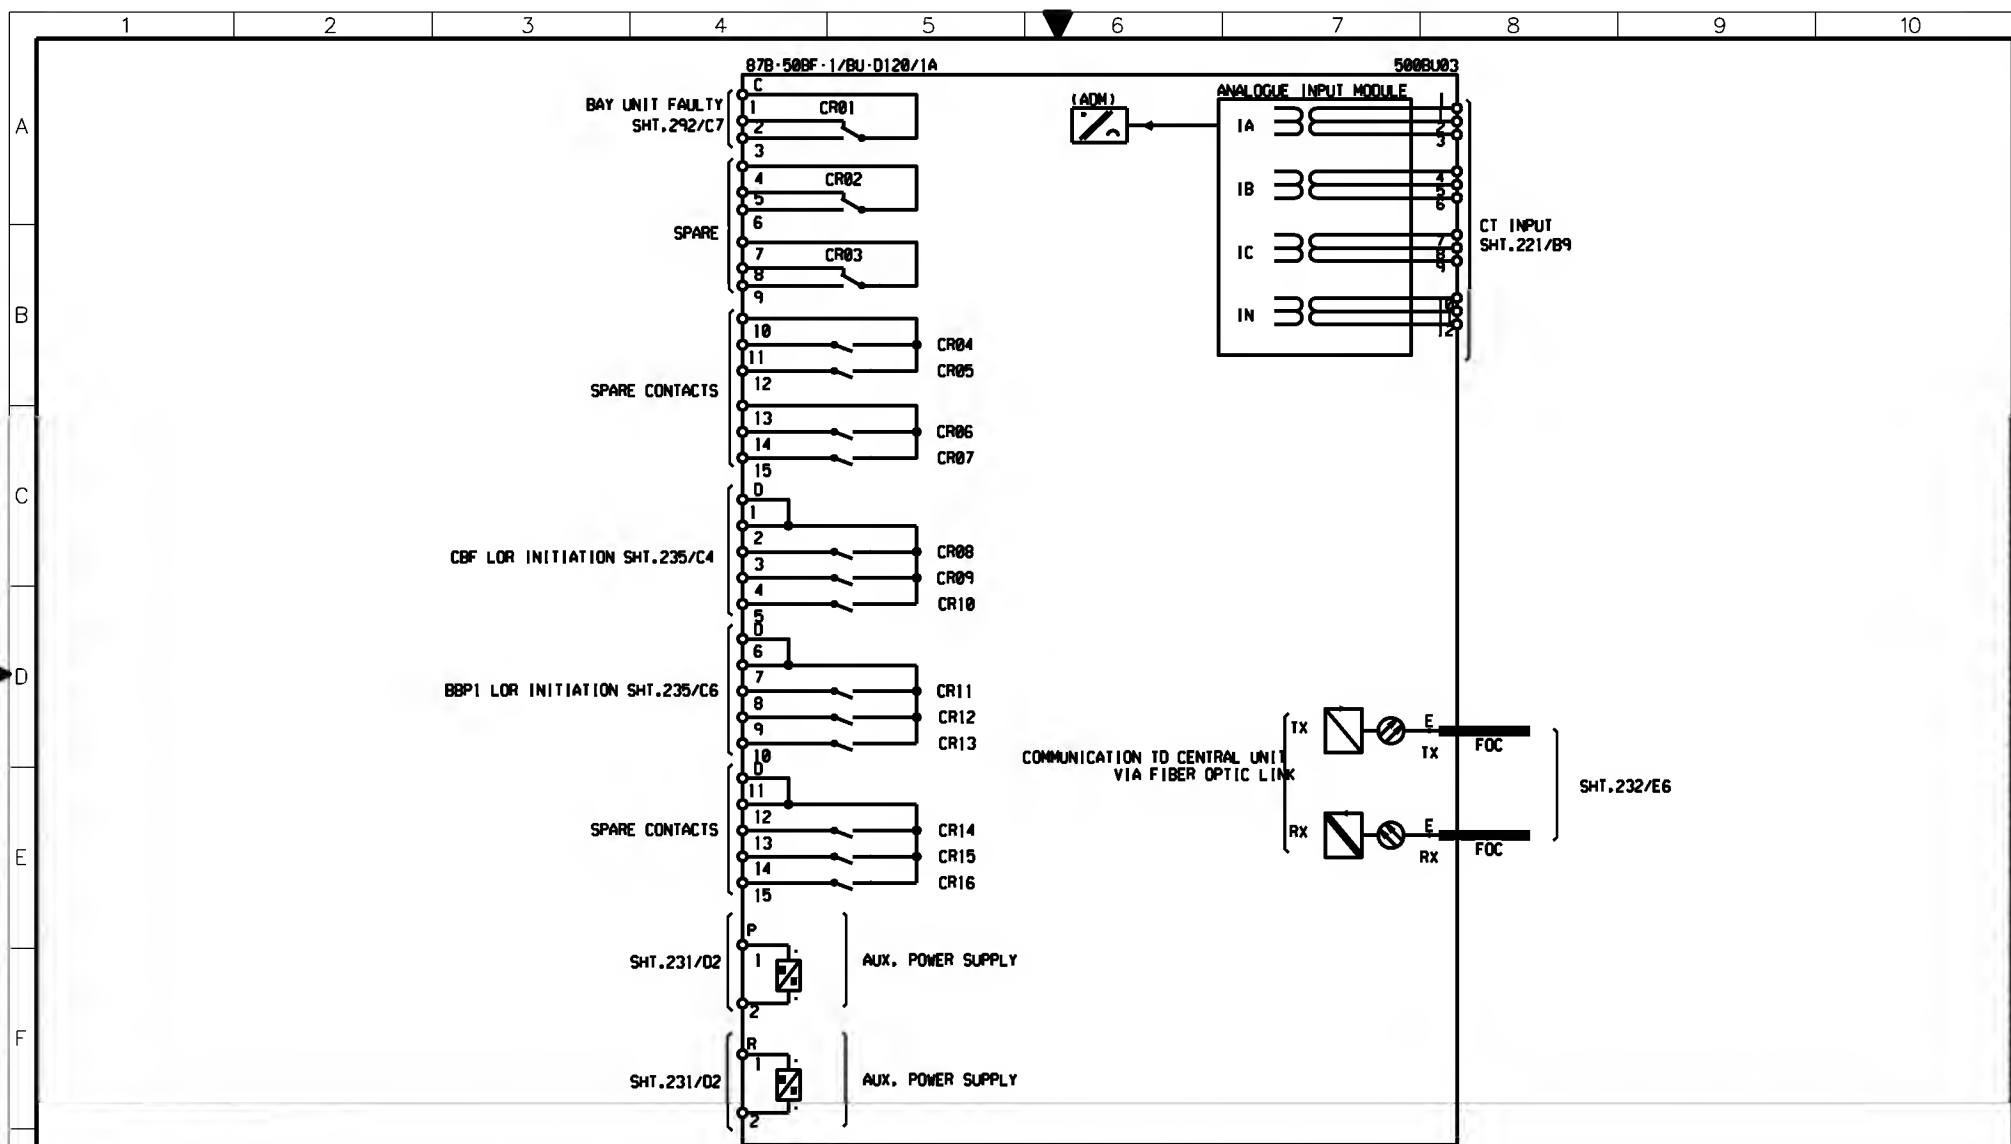


AS-BUILT BY _____ DATE _____		CONTRACT NO. 11131113/00	JOB ORDER NO. S-13656	BLOCK REFERENCE-87B+50BF-1/BU-D120/1A		الشركة الوطنية لنقل الكهرباء		نقل الكهرباء	
01 13 49		FACTORY ASBUILT		DRAWN BY RIZ CHECKED BY KVR		132KV BUSBAR PROTN.MAIN-1 BU PANEL +BBP1-4		National Grid sa	
00 13 05		FOR APPROVAL		DATE STARTED 28.01.2013 DATE COMPLETED _____		S/S 8709 - 132/13.8KV IN AL-KHARJ CITY		INDEX PLANT NO. DRAWING NUMBER SHEET NO. REV. NO.	
REV. NO. DATE DESCRIPTION		OPRG. DEPT. CTPD ENG. DEPT. AUT-PSAC		RIYADH SAUDI ARABIA		- C421 CD-322997		SHT. CONT. 293 294 01	

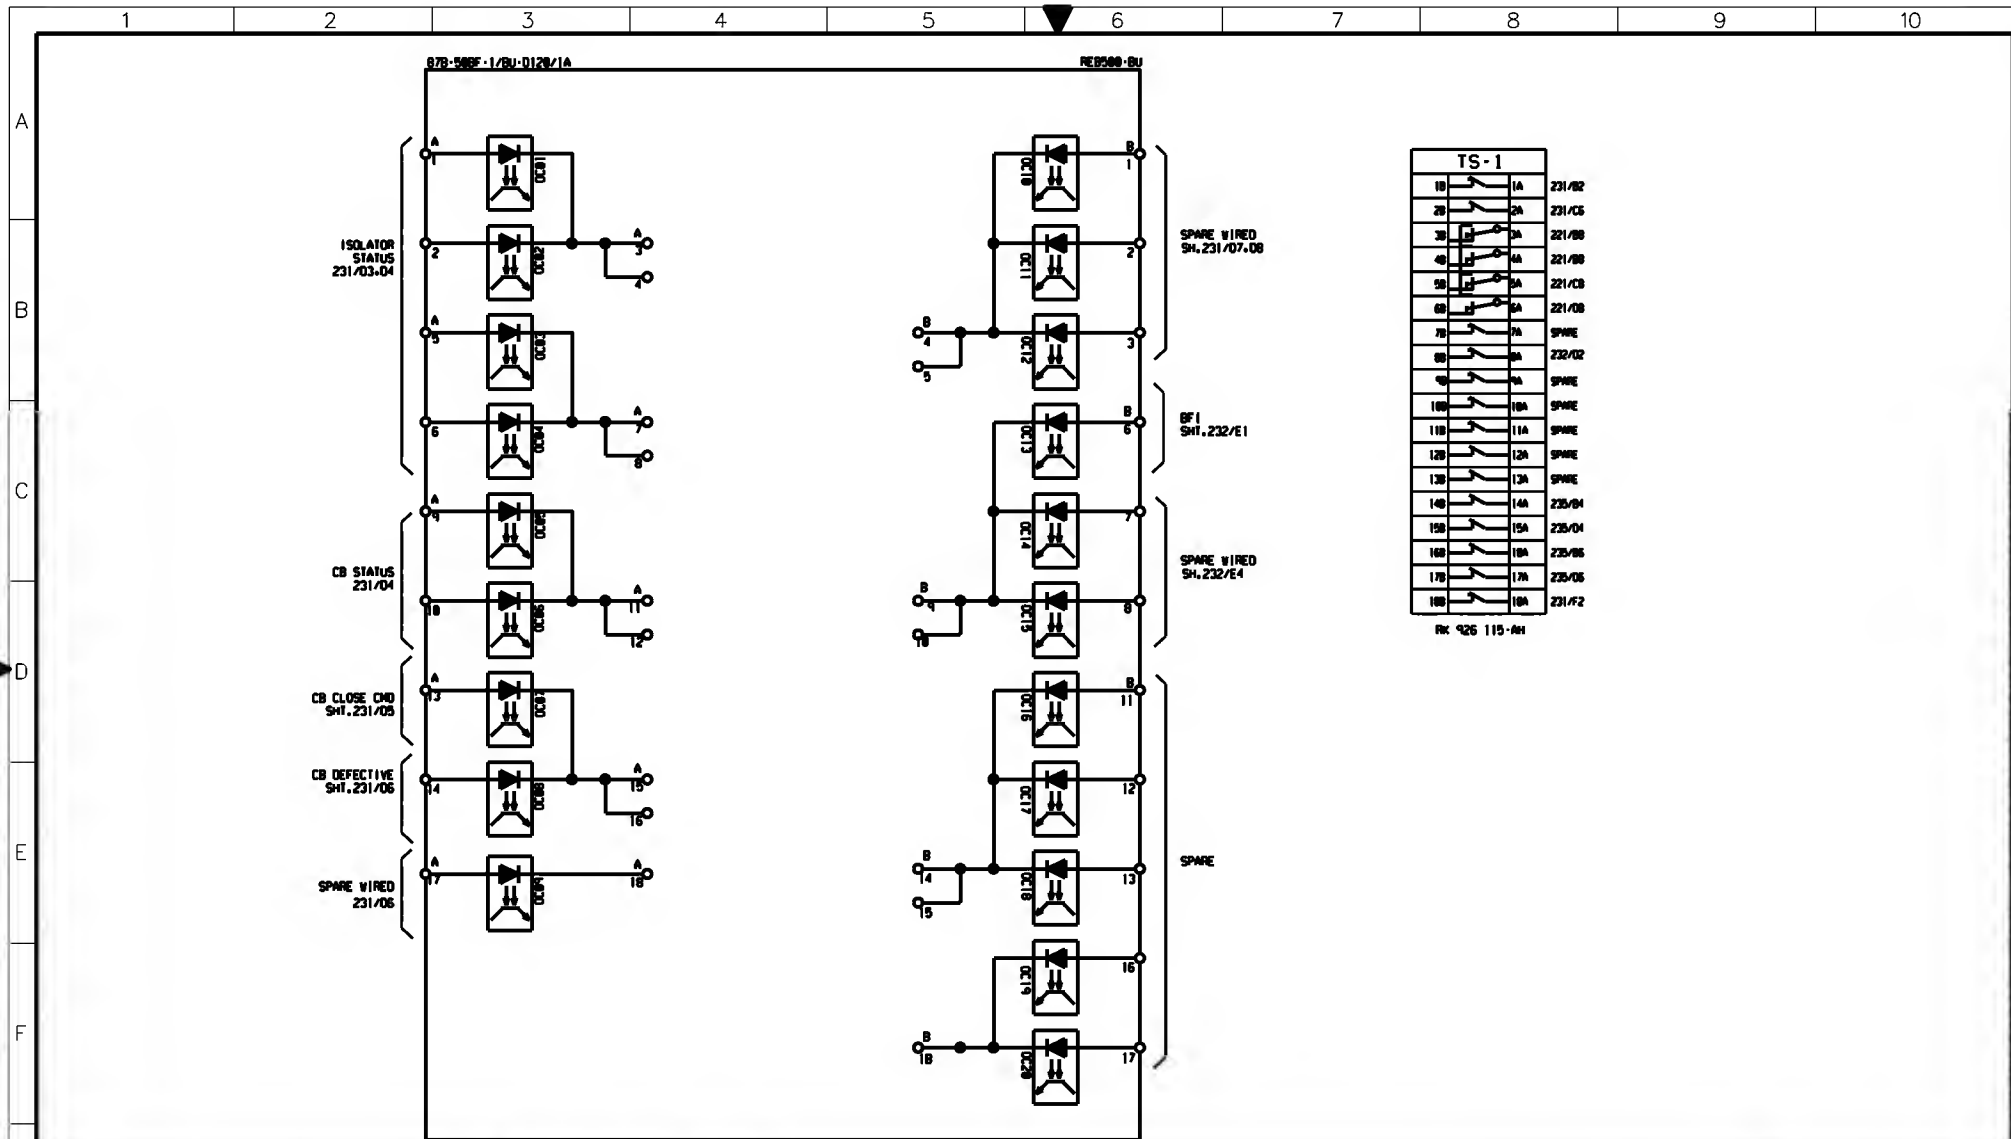


AS-BUILT BY _____ DATE _____		CONTRACT NO. 1113113/00		JOB ORDER NO. S-13656		BLOCK REFERENCE-87B+50BF-1/BU-D120/1A		الشركة الوطنية لنقل الكهرباء		نقل الكهرباء	
DRAWN BY RIZ		CHECKED BY KVR		DATE STARTED 28.01.2013		DATE COMPLETED _____		132KV BUSBAR PROTN.MAIN-1 BU PANEL +88P1-4		National Grid sa	
PRG. DEPT. CTPD		ENG. DEPT. AUT-PSAC		S/S 8709 - 132/13.8KV IN AL-KHARJ CITY		RIYADH		SAUDI ARABIA		INDEX PLANT NO. C421	
DRAWING NUMBER CD-322997		SHEET NO. 294		CONT. 295		REV. NO. 01		DMS		VECTOR	

THIS DRAWING AND THE INFORMATION CONTAINED HEREIN ARE THE SOLE PROPERTY OF NATIONAL GRID SA. NO REPRODUCTION OR TRANSMISSION IN ANY FORM OR BY ANY MEANS, WITHOUT THE WRITTEN CONSENT OF ITS OWNER.

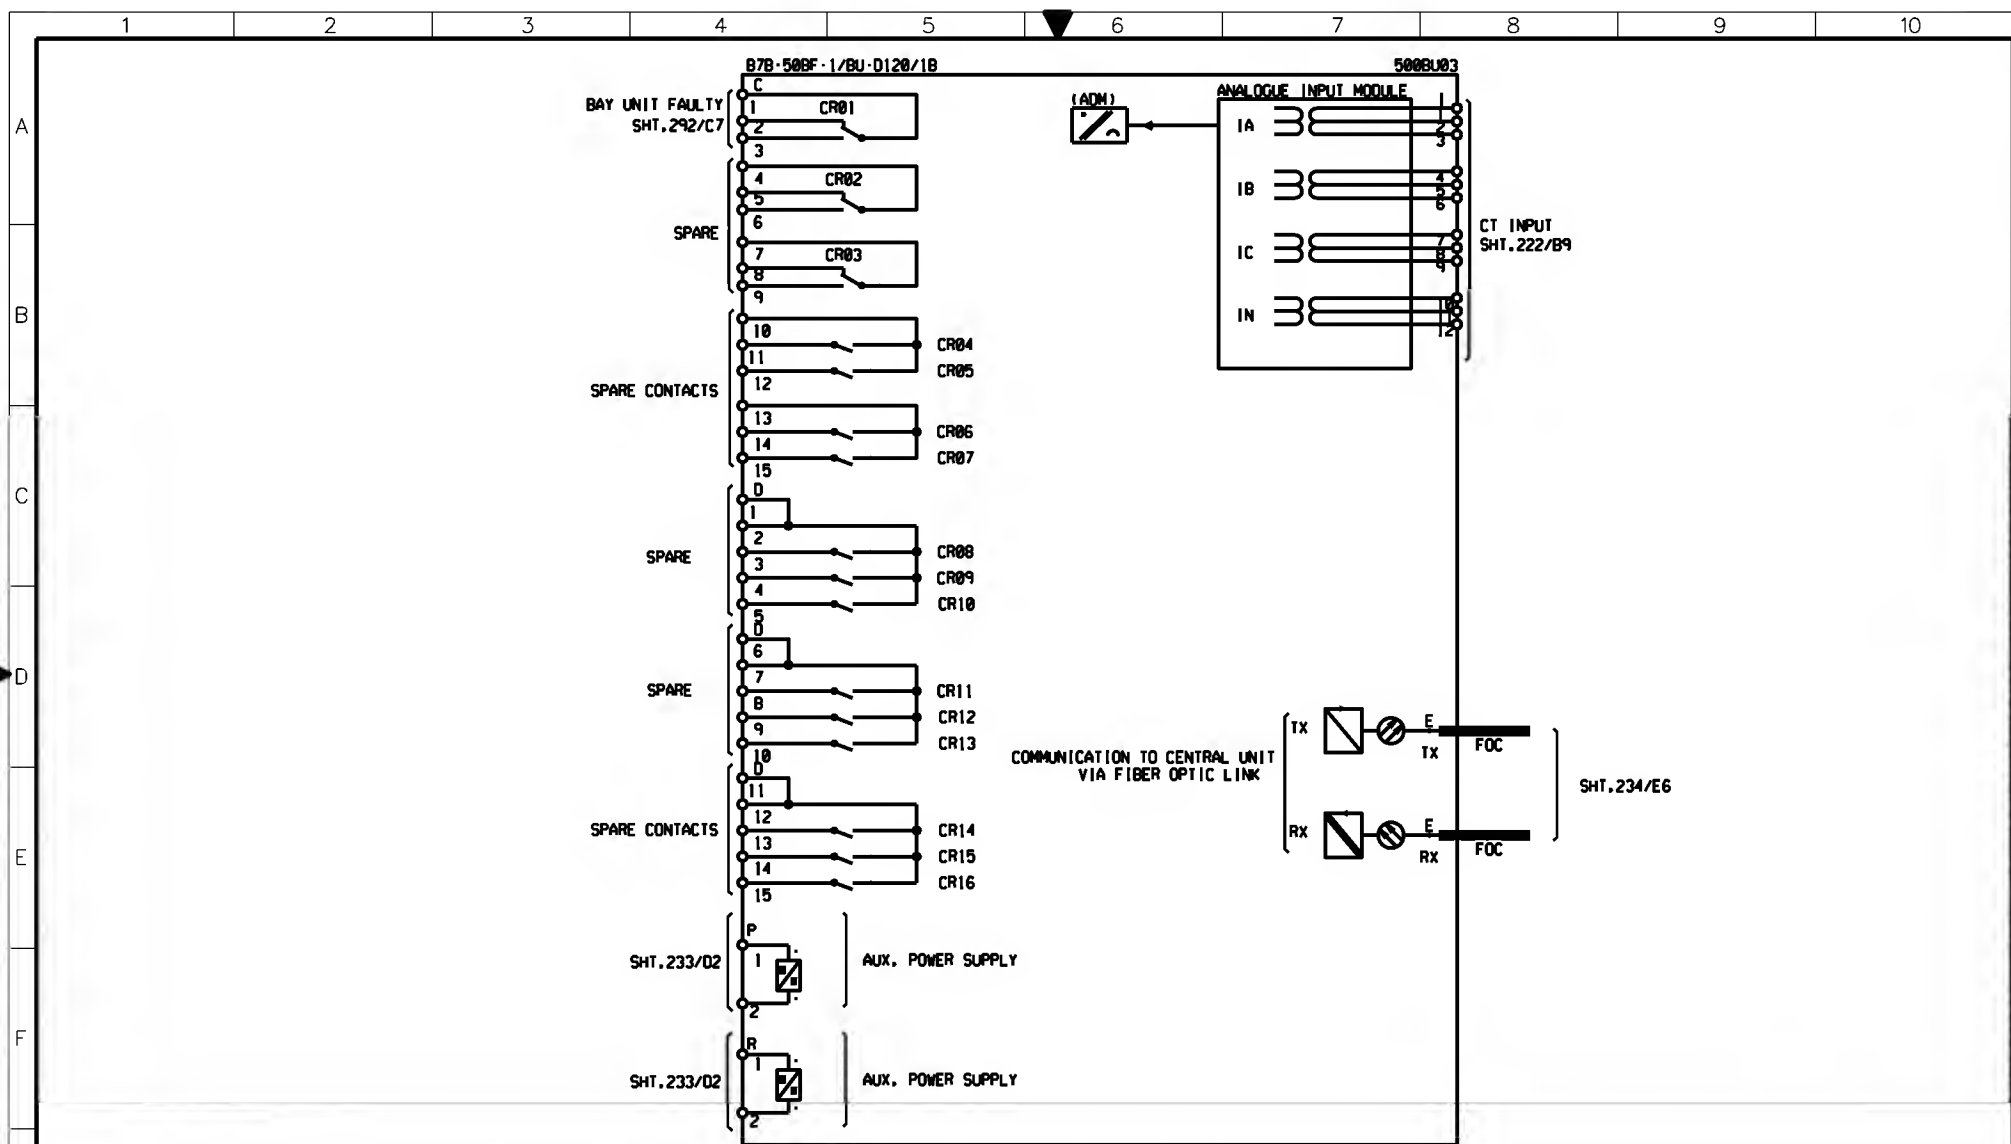

AS-BUILT BY _____ DATE _____		CONTRACT NO. 11131113/00		JOB ORDER NO. S-13656		BLOCK REFERENCE-87B+50BF-1/BU-D120/1B		الشركة الوطنية لنقل الكهرباء	
DRAWN BY RIZ CHECKED BY KVR		DATE STARTED 28.01.2013 DATE COMPLETED _____		132KV BUSBAR PROTN.MAIN-1 BU PANEL +BBP1-4		S/S 8709 - 132/13.8KV IN AL-KHARJ CITY		National Grid sa	
PRG. DEPT. CTPD ENG. DEPT. AUT-PSAC		INDEX PLANT NO. C421		DRAWING NUMBER CD-322997		SHEET NO. 295		REV. NO. 01	
DESCRIPTION		CONT.		SHT.234/E6		SHT.233/02		SHT.233/02	

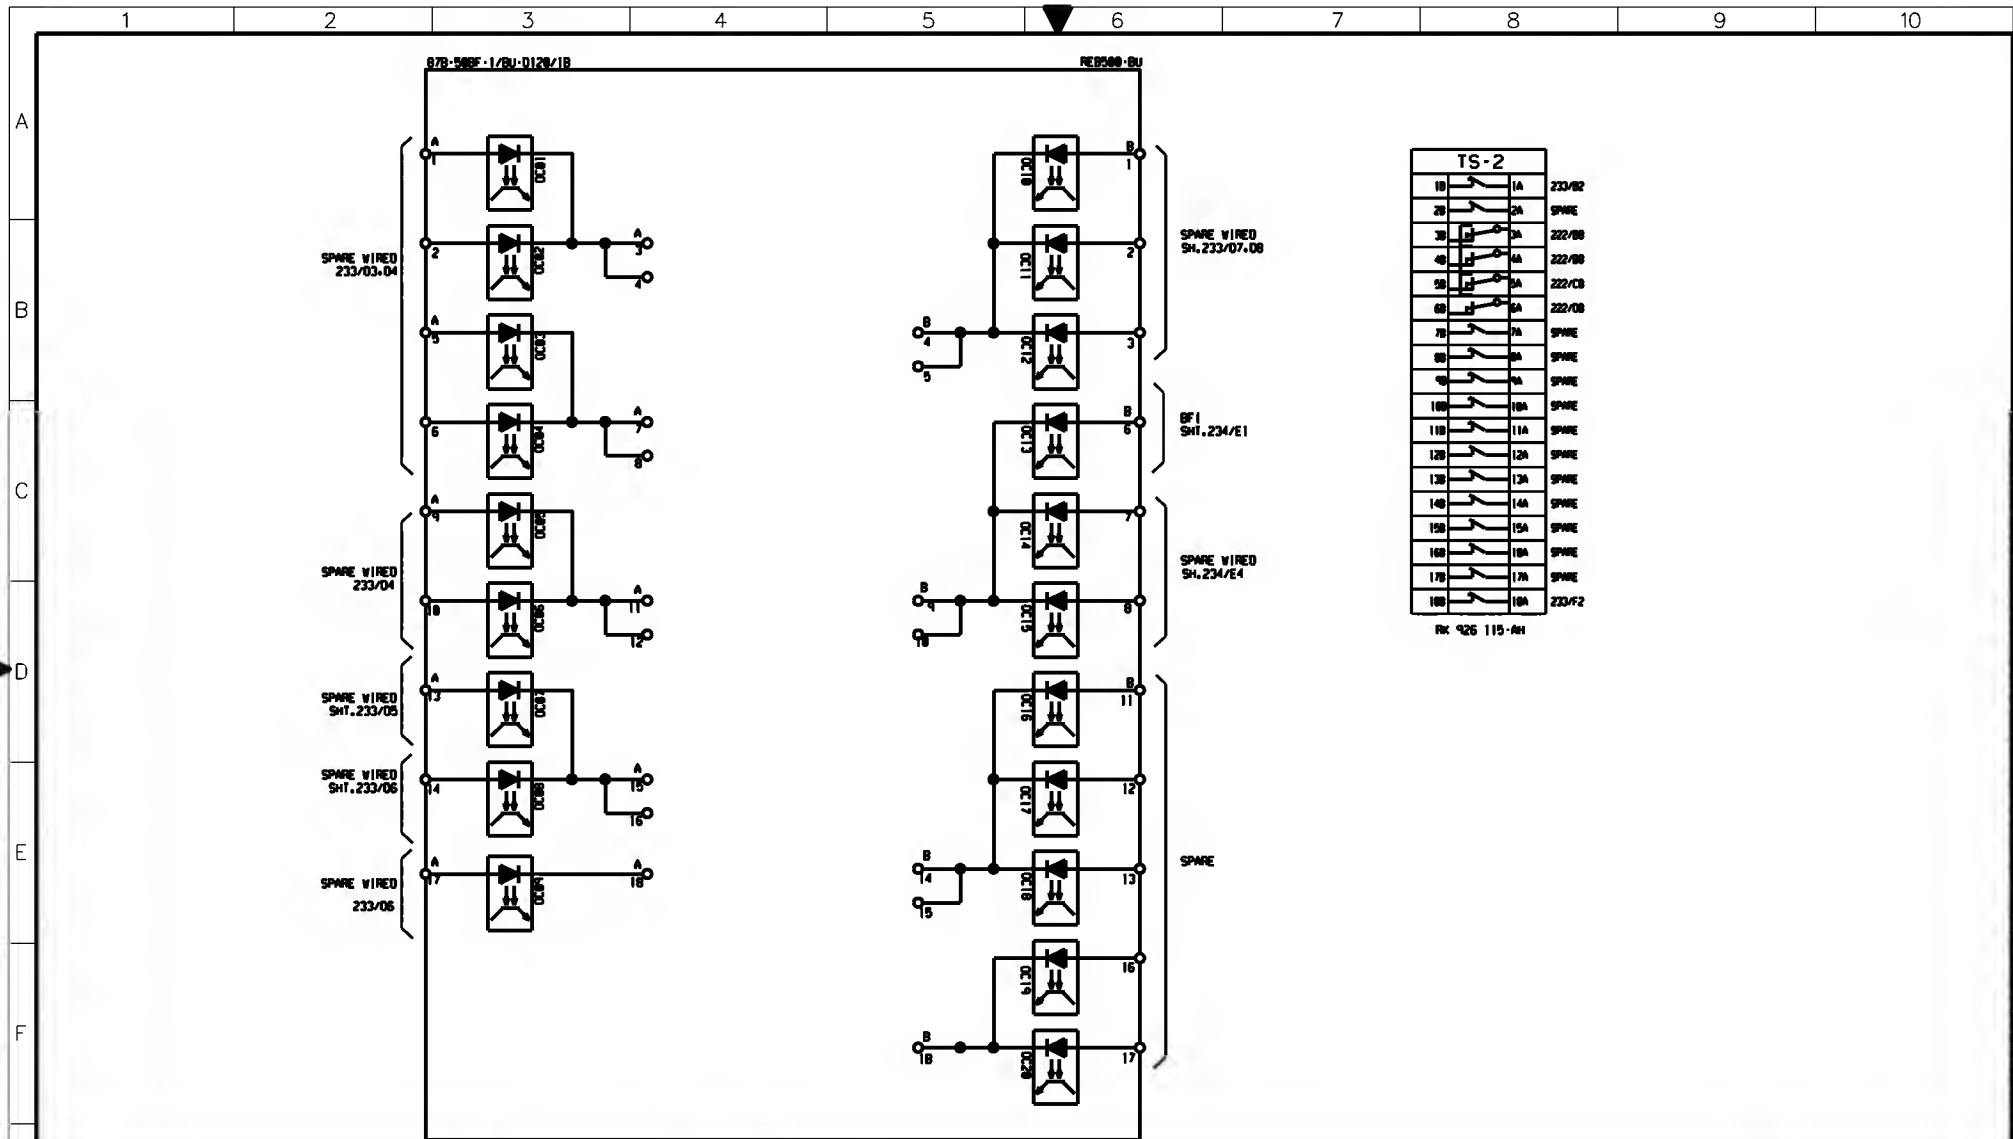

AS-BUILT BY \_\_\_\_\_ DATE \_\_\_\_\_ CONTRACT NO. **1113113/00** JOB ORDER NO. **S-13656**

01	13 49	FACTORY ASBUILT
00	13 05	FOR APPROVAL
REV. NO.	DATE	DESCRIPTION

DRAWN BY **RIZ** CHECKED BY **KVR**

DATE STARTED **28.01.2013** DATE COMPLETED \_\_\_\_\_

PRG. DEPT. **CTPD** ENG. DEPT. **AUT-PSAC**

**BLOCK REFERENCE-87B+50BF-1/BU-D120/1B**

**132KV BUSBAR PROTN.MAIN-1 BU PANEL +BBP1-4**

**S/S 8709 - 132/13.8KV IN AL-KHARJ CITY**

**RIYADH SAUDI ARABIA**

الشركة الوطنية لنقل الكهرباء


نقل الكهرباء

National Grid sa

INDEX	PLANT NO.	DRAWING NUMBER	SHEET NO.	REV. NO.
-	C421	CD-322997	296 297	01

THIS DRAWING AND THE INFORMATION CONTAINED HEREIN ARE THE SOLE PROPERTY OF NATIONAL GRID SA. NO REPRODUCTION OR TRANSMISSION IN ANY FORM OR BY ANY MEANS, WITHOUT THE WRITTEN CONSENT OF ITS OWNER.



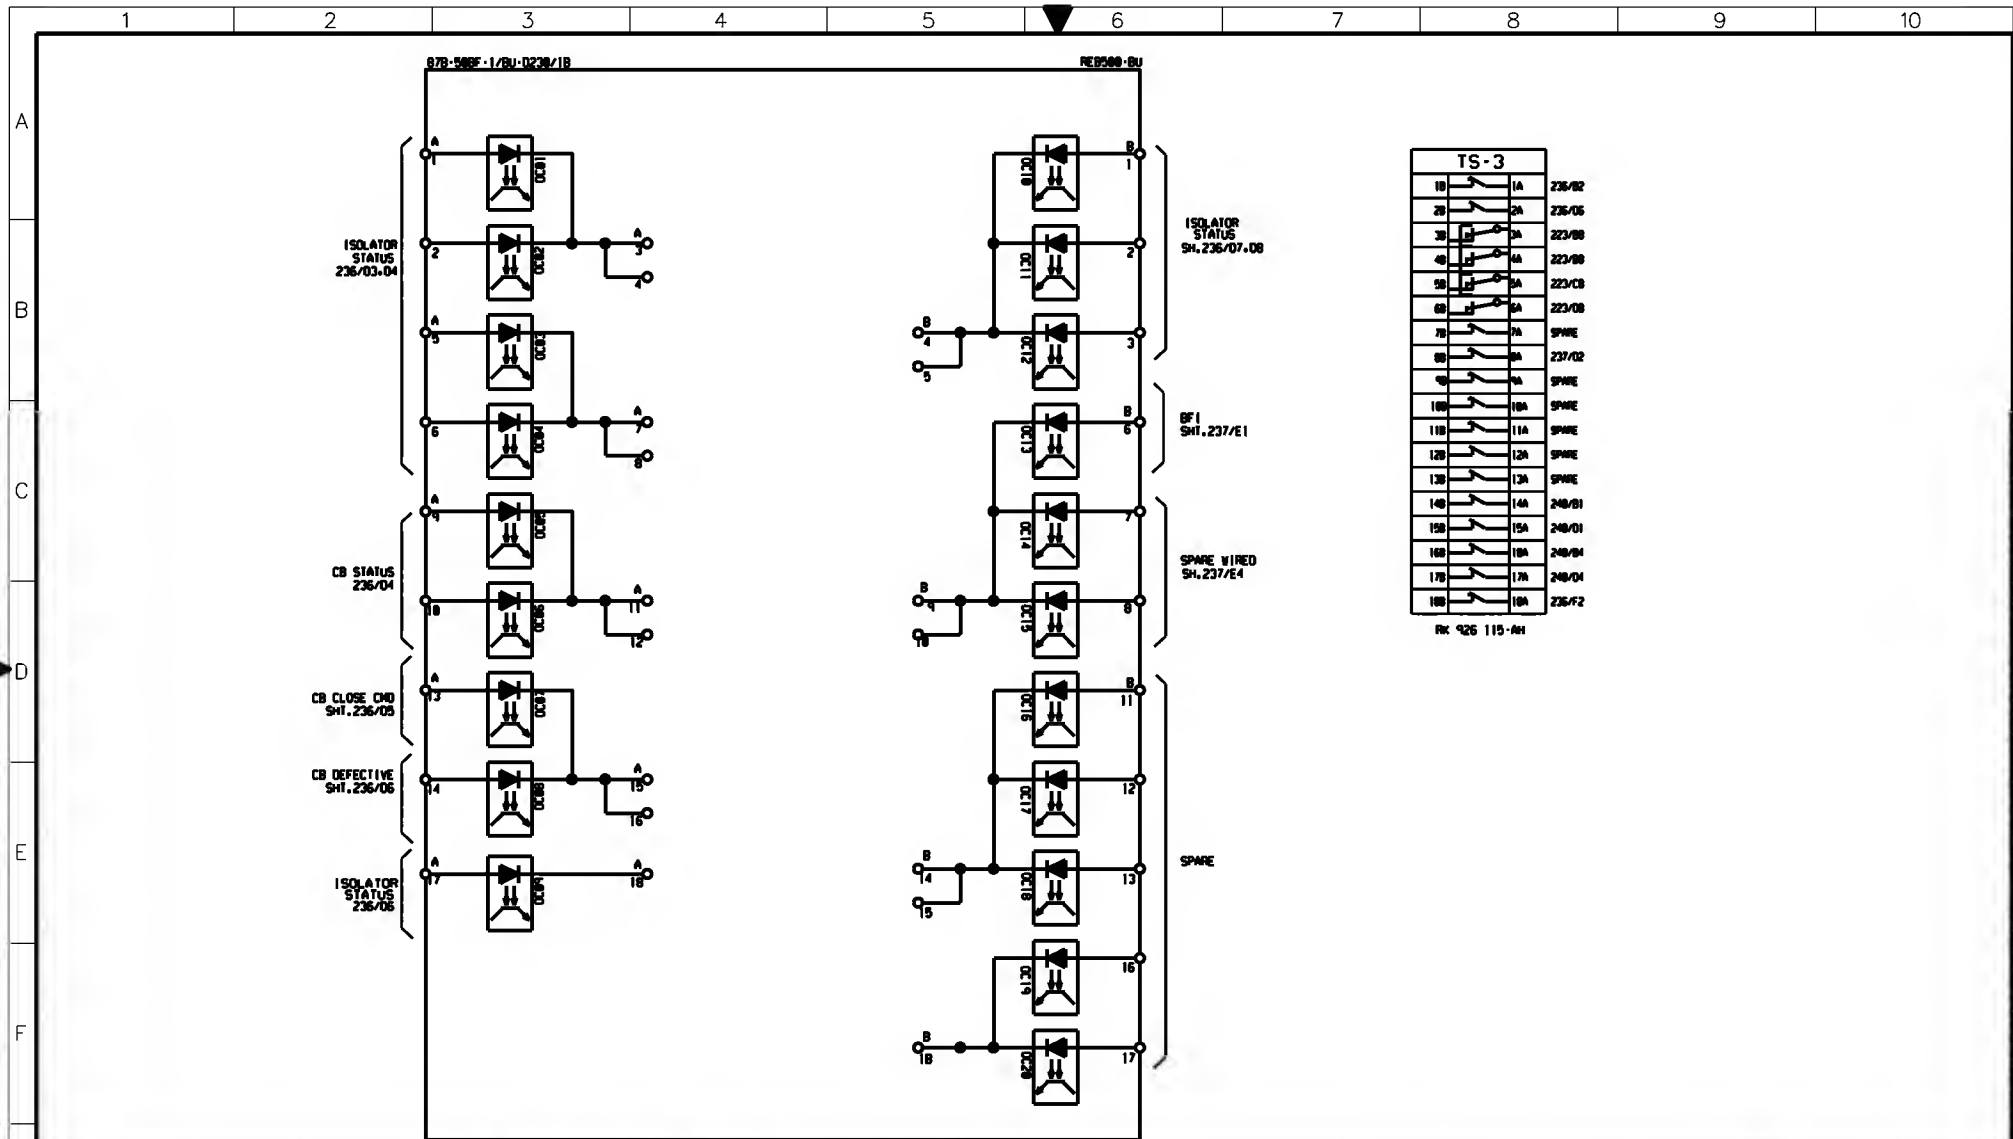

AS-BUILT BY \_\_\_\_\_ DATE \_\_\_\_\_ CONTRACT NO. **1113113/00** JOB ORDER NO. **S-13656**

01	13 49	FACTORY ASBUILT
00	13 05	FOR APPROVAL
REV. NO.	DATE	DESCRIPTION

DRAWN BY **RIZ** CHECKED BY **KVR**

DATE STARTED **28.01.2013** DATE COMPLETED \_\_\_\_\_

OPRG. DEPT. **CTPD** ENG. DEPT. **AUT-PSAC**

**BLOCK REFERENCE-87B+50BF-1/BU-D230/18**


**132KV BUSBAR PROT.N.MAIN-1 BU PANEL +BBP1-4**

**S/S 8709 - 132/13.8KV IN AL-KHARJ CITY**

**RIYADH SAUDI ARABIA**


الشركة الوطنية لنقل الكهرباء		نقل الكهرباء	
		National Grid sa	
INDEX	PLANT NO.	DRAWING NUMBER	SHEET NO.
-	C421	CD-322997	298 299
			REV. NO.
			01

THIS DRAWING AND THE INFORMATION CONTAINED HEREIN ARE THE SOLE PROPERTY OF NATIONAL GRID SA. NO REPRODUCTION IN FULL OR IN PART SHALL BE OBTAINED FROM THIS DOCUMENT WITHOUT THE WRITTEN CONSENT OF ITS OWNER.

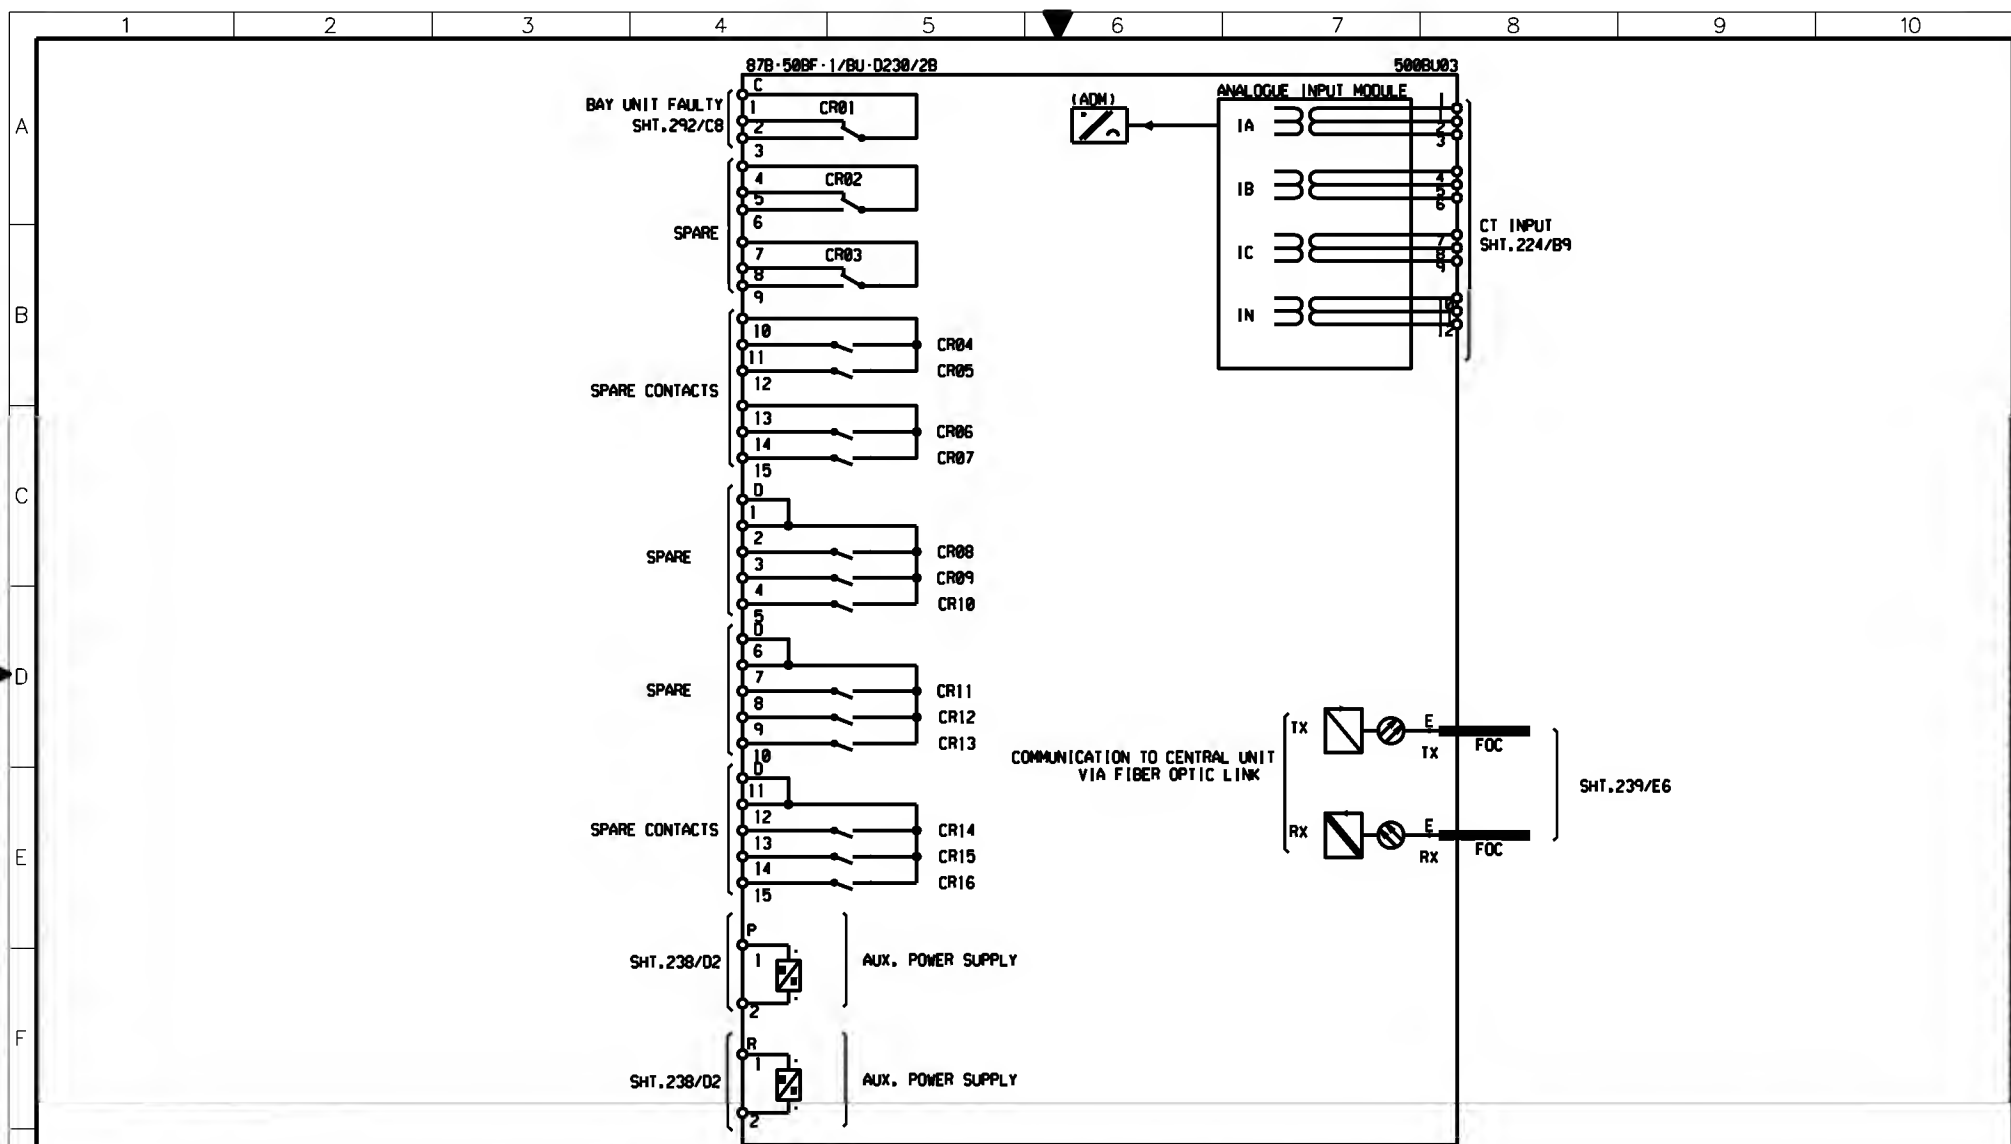

AS-BUILT BY _____ DATE _____			CONTRACT NO. 11131113/00		JOB ORDER NO. S-13656		BLOCK REFERENCE-87B+50BF-1/BU-D230/28			الشركة الوطنية لنقل الكهرباء			
01 13 49			DRAWN BY RIZ		CHECKED BY KVR		132KV BUSBAR PROTN.MAIN-1 BU PANEL +BBPI-4			National Grid sa			
00 13 05			DATE STARTED 28.01.2013		DATE COMPLETED _____		S/S 8709 - 132/13.8KV IN AL-KHARJ CITY			INDEX PLANT NO. DRAWING NUMBER SHEET NO. REV. NO.			
FOR APPROVAL			PRG. DEPT. CTPD		ENG. DEPT. AUT-PSAC		RIYADH SAUDI ARABIA			- C421 CD-322997 299 300 01			



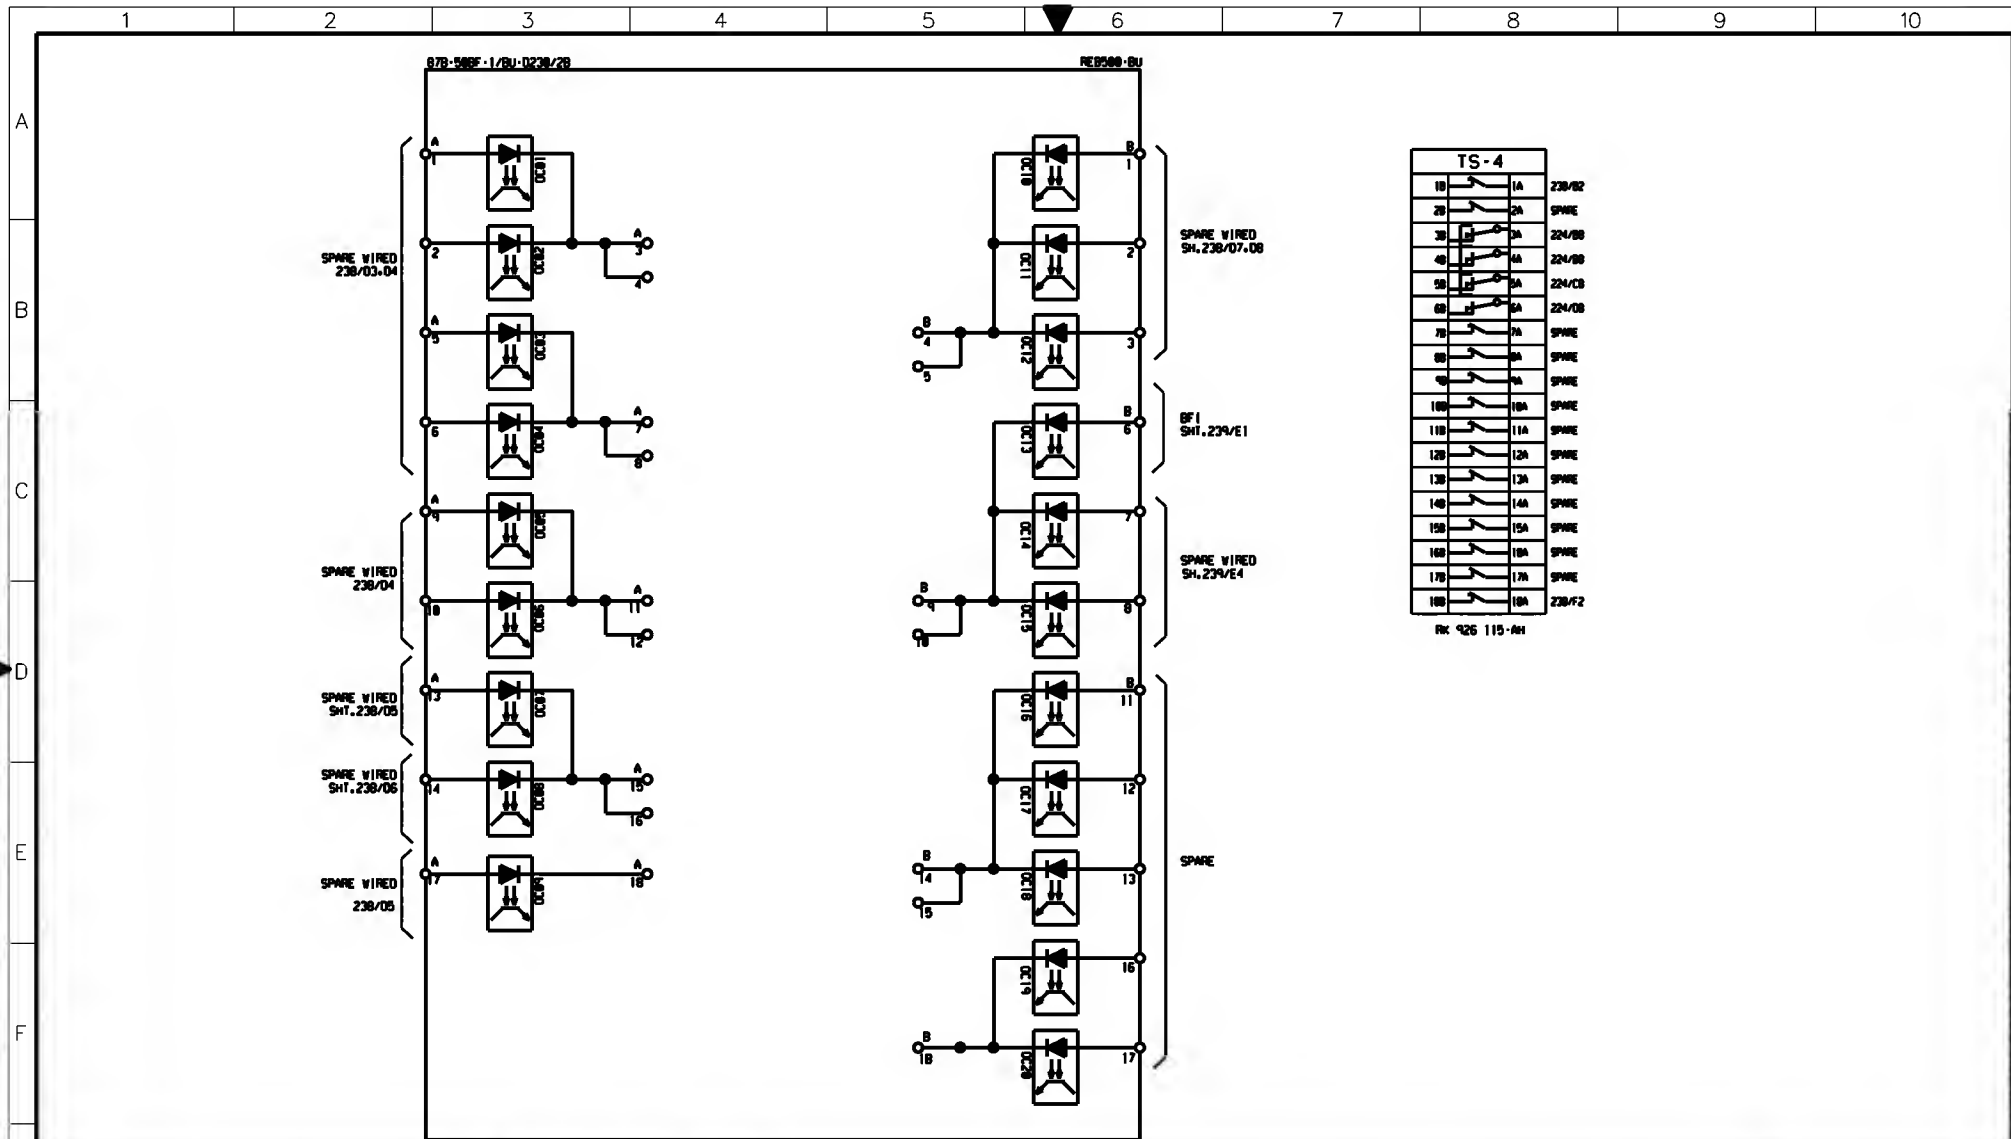

AS-BUILT BY _____ DATE _____		CONTRACT NO. 1113113/00	JOB ORDER NO. S-13656	BLOCK REFERENCE-878+50BF-1/BU-D230/28		الشركة الوطنية لنقل الكهرباء		نقل الكهرباء	
01	13 49	FACTORY ASBUILT		DRAWN BY RIZ	CHECKED BY KVR	132KV BUSBAR PROTN.MAIN-1 BU PANEL +BBP1-4		National Grid sa	
00	13 05	FOR APPROVAL		DATE STARTED 28.01.2013 DATE COMPLETED _____		S/S 8709 - 132/13.8KV IN AL-KHARJ CITY		INDEX PLANT NO. DRAWING NUMBER SHEET NO. REV. NO.	
REV. NO.	DATE	DESCRIPTION		OPRG. DEPT. CTPD ENG. DEPT. AUT-PSAC		- C421 CD-322997 300 301 01			

	1	2	3	4	5	6	7	8	9	10																																																																																																																																																																																																																																																																																																																																																																																																																																														
A	<table> <tr><th>REFERENCE</th><th>1X1 CT CKT.</th></tr> <tr><td>221/B7</td><td>1</td></tr> <tr><td>221/B7</td><td>2</td></tr> <tr><td>221/C7</td><td>3</td></tr> <tr><td>221/C7</td><td>4</td></tr> <tr><td>221/C7</td><td>5</td></tr> <tr><td>221/C7</td><td>6</td></tr> <tr><td>221/C7</td><td>7</td></tr> <tr><td>221/D7</td><td>8</td></tr> <tr><td>221/D7</td><td>9</td></tr> <tr><td>SPARE</td><td>10</td></tr> <tr><td>222/B7</td><td>11</td></tr> <tr><td>222/B7</td><td>12</td></tr> <tr><td>222/C7</td><td>13</td></tr> <tr><td>222/C7</td><td>14</td></tr> <tr><td>222/C7</td><td>15</td></tr> <tr><td>222/C7</td><td>16</td></tr> <tr><td>222/C7</td><td>17</td></tr> <tr><td>222/D7</td><td>18</td></tr> <tr><td>222/D7</td><td>19</td></tr> <tr><td>SPARE</td><td>20</td></tr> <tr><td>SPARE</td><td>21</td></tr> <tr><td>SPARE</td><td>22</td></tr> <tr><td>SPARE</td><td>23</td></tr> <tr><td>SPARE</td><td>24</td></tr> <tr><td>SPARE</td><td>25</td></tr> </table>	REFERENCE	1X1 CT CKT.	221/B7	1	221/B7	2	221/C7	3	221/C7	4	221/C7	5	221/C7	6	221/C7	7	221/D7	8	221/D7	9	SPARE	10	222/B7	11	222/B7	12	222/C7	13	222/C7	14	222/C7	15	222/C7	16	222/C7	17	222/D7	18	222/D7	19	SPARE	20	SPARE	21	SPARE	22	SPARE	23	SPARE	24	SPARE	25	<table> <tr><th>REFERENCE</th><th>2X1 CT CKT.</th></tr> <tr><td>223/B7</td><td>1</td></tr> <tr><td>223/B7</td><td>2</td></tr> <tr><td>223/C7</td><td>3</td></tr> <tr><td>223/C7</td><td>4</td></tr> <tr><td>223/C7</td><td>5</td></tr> <tr><td>223/C7</td><td>6</td></tr> <tr><td>223/C7</td><td>7</td></tr> <tr><td>223/D7</td><td>8</td></tr> <tr><td>223/D7</td><td>9</td></tr> <tr><td>SPARE</td><td>10</td></tr> <tr><td>224/B7</td><td>11</td></tr> <tr><td>224/B7</td><td>12</td></tr> <tr><td>224/C7</td><td>13</td></tr> <tr><td>224/C7</td><td>14</td></tr> <tr><td>224/C7</td><td>15</td></tr> <tr><td>224/C7</td><td>16</td></tr> <tr><td>224/C7</td><td>17</td></tr> <tr><td>224/D7</td><td>18</td></tr> <tr><td>224/D7</td><td>19</td></tr> <tr><td>SPARE</td><td>20</td></tr> <tr><td>SPARE</td><td>21</td></tr> <tr><td>SPARE</td><td>22</td></tr> <tr><td>SPARE</td><td>23</td></tr> <tr><td>SPARE</td><td>24</td></tr> <tr><td>SPARE</td><td>25</td></tr> </table>	REFERENCE	2X1 CT CKT.	223/B7	1	223/B7	2	223/C7	3	223/C7	4	223/C7	5	223/C7	6	223/C7	7	223/D7	8	223/D7	9	SPARE	10	224/B7	11	224/B7	12	224/C7	13	224/C7	14	224/C7	15	224/C7	16	224/C7	17	224/D7	18	224/D7	19	SPARE	20	SPARE	21	SPARE	22	SPARE	23	SPARE	24	SPARE	25	<table> <tr><th>REFERENCE</th><th>1X51 CON &amp; PROTIN CKTS.</th></tr> <tr><td>231/A3</td><td>1</td></tr> <tr><td>231/A6</td><td>2</td></tr> <tr><td>231/A7</td><td>3</td></tr> <tr><td>231/A6</td><td>4</td></tr> <tr><td>231/C3</td><td>5</td></tr> <tr><td>231/C4</td><td>6</td></tr> <tr><td>231/C4</td><td>7</td></tr> <tr><td>231/C4</td><td>8</td></tr> <tr><td>231/C5</td><td>9</td></tr> <tr><td>231/C5</td><td>10</td></tr> <tr><td>231/C6</td><td>11</td></tr> <tr><td>231/C6</td><td>12</td></tr> <tr><td>231/C7</td><td>13</td></tr> <tr><td>231/C7</td><td>14</td></tr> <tr><td>231/C8</td><td>15</td></tr> <tr><td>231/C8</td><td>16</td></tr> <tr><td>232/A2</td><td>17</td></tr> <tr><td>232/A2</td><td>18</td></tr> <tr><td>232/A3</td><td>19</td></tr> <tr><td>232/A4</td><td>20</td></tr> <tr><td>232/A4</td><td>21</td></tr> <tr><td>232/A5</td><td>22</td></tr> <tr><td>232/C2</td><td>23</td></tr> <tr><td>232/D4</td><td>24</td></tr> <tr><td>232/D5</td><td>25</td></tr> <tr><td>233/A3</td><td>26</td></tr> <tr><td>233/A6</td><td>27</td></tr> <tr><td>233/A7</td><td>28</td></tr> <tr><td>233/A6</td><td>29</td></tr> <tr><td>233/C3</td><td>30</td></tr> <tr><td>233/C4</td><td>31</td></tr> <tr><td>233/C4</td><td>32</td></tr> <tr><td>233/C4</td><td>33</td></tr> <tr><td>233/C5</td><td>34</td></tr> <tr><td>233/C5</td><td>35</td></tr> <tr><td>233/C6</td><td>36</td></tr> <tr><td>233/C6</td><td>37</td></tr> <tr><td>233/C7</td><td>38</td></tr> <tr><td>233/C7</td><td>39</td></tr> <tr><td>233/C8</td><td>40</td></tr> <tr><td>233/C8</td><td>41</td></tr> <tr><td>234/A2</td><td>42</td></tr> <tr><td>234/A2</td><td>43</td></tr> <tr><td>234/A3</td><td>44</td></tr> <tr><td>234/A4</td><td>45</td></tr> <tr><td>234/A4</td><td>46</td></tr> <tr><td>234/A5</td><td>47</td></tr> <tr><td>234/C2</td><td>48</td></tr> <tr><td>234/D4</td><td>49</td></tr> <tr><td>234/D5</td><td>50</td></tr> </table>	REFERENCE	1X51 CON & PROTIN CKTS.	231/A3	1	231/A6	2	231/A7	3	231/A6	4	231/C3	5	231/C4	6	231/C4	7	231/C4	8	231/C5	9	231/C5	10	231/C6	11	231/C6	12	231/C7	13	231/C7	14	231/C8	15	231/C8	16	232/A2	17	232/A2	18	232/A3	19	232/A4	20	232/A4	21	232/A5	22	232/C2	23	232/D4	24	232/D5	25	233/A3	26	233/A6	27	233/A7	28	233/A6	29	233/C3	30	233/C4	31	233/C4	32	233/C4	33	233/C5	34	233/C5	35	233/C6	36	233/C6	37	233/C7	38	233/C7	39	233/C8	40	233/C8	41	234/A2	42	234/A2	43	234/A3	44	234/A4	45	234/A4	46	234/A5	47	234/C2	48	234/D4	49	234/D5	50	<table> <tr><th>REFERENCE</th><th>1X51 CON &amp; PROTIN CKTS.</th></tr> <tr><td>234/B6</td><td>51</td></tr> <tr><td>234/F6</td><td>52</td></tr> <tr><td>234/B6</td><td>53</td></tr> <tr><td>234/F6</td><td>54</td></tr> <tr><td>235/E4</td><td>55</td></tr> <tr><td>235/E4</td><td>56</td></tr> <tr><td>235/E6</td><td>57</td></tr> <tr><td>235/E7</td><td>58</td></tr> <tr><td>SPARE</td><td>59</td></tr> <tr><td>SPARE</td><td>60</td></tr> <tr><td>SPARE</td><td>61</td></tr> <tr><td>SPARE</td><td>62</td></tr> <tr><td>SPARE</td><td>63</td></tr> <tr><td>SPARE</td><td>64</td></tr> <tr><td>SPARE</td><td>65</td></tr> <tr><td>SPARE</td><td>66</td></tr> <tr><td>SPARE</td><td>67</td></tr> <tr><td>SPARE</td><td>68</td></tr> <tr><td>SPARE</td><td>69</td></tr> <tr><td>SPARE</td><td>70</td></tr> <tr><td>SPARE</td><td>71</td></tr> <tr><td>SPARE</td><td>72</td></tr> <tr><td>SPARE</td><td>73</td></tr> <tr><td>SPARE</td><td>74</td></tr> <tr><td>SPARE</td><td>75</td></tr> </table>	REFERENCE	1X51 CON & PROTIN CKTS.	234/B6	51	234/F6	52	234/B6	53	234/F6	54	235/E4	55	235/E4	56	235/E6	57	235/E7	58	SPARE	59	SPARE	60	SPARE	61	SPARE	62	SPARE	63	SPARE	64	SPARE	65	SPARE	66	SPARE	67	SPARE	68	SPARE	69	SPARE	70	SPARE	71	SPARE	72	SPARE	73	SPARE	74	SPARE	75	<table> <tr><th>REFERENCE</th><th>2X51 CON &amp; PROTIN CKTS.</th></tr> <tr><td>236/A3</td><td>1</td></tr> <tr><td>236/A6</td><td>2</td></tr> <tr><td>236/A7</td><td>3</td></tr> <tr><td>236/A8</td><td>4</td></tr> <tr><td>236/C3</td><td>5</td></tr> <tr><td>236/C4</td><td>6</td></tr> <tr><td>236/C4</td><td>7</td></tr> <tr><td>236/C4</td><td>8</td></tr> <tr><td>236/C5</td><td>9</td></tr> <tr><td>236/C5</td><td>10</td></tr> <tr><td>236/C6</td><td>11</td></tr> <tr><td>236/C6</td><td>12</td></tr> <tr><td>236/C7</td><td>13</td></tr> <tr><td>236/C7</td><td>14</td></tr> <tr><td>236/C8</td><td>15</td></tr> <tr><td>236/C8</td><td>16</td></tr> <tr><td>237/A2</td><td>17</td></tr> <tr><td>237/A2</td><td>18</td></tr> <tr><td>237/A3</td><td>19</td></tr> <tr><td>237/A4</td><td>20</td></tr> <tr><td>237/A4</td><td>21</td></tr> <tr><td>237/A5</td><td>22</td></tr> <tr><td>237/C2</td><td>23</td></tr> <tr><td>237/D4</td><td>24</td></tr> <tr><td>237/D5</td><td>25</td></tr> <tr><td>236/A3</td><td>26</td></tr> <tr><td>236/A6</td><td>27</td></tr> <tr><td>236/A7</td><td>28</td></tr> <tr><td>236/A8</td><td>29</td></tr> <tr><td>236/C3</td><td>30</td></tr> <tr><td>236/C4</td><td>31</td></tr> <tr><td>236/C4</td><td>32</td></tr> <tr><td>236/C5</td><td>33</td></tr> <tr><td>236/C5</td><td>34</td></tr> <tr><td>236/C6</td><td>35</td></tr> <tr><td>236/C6</td><td>36</td></tr> <tr><td>236/C7</td><td>37</td></tr> <tr><td>236/C7</td><td>38</td></tr> <tr><td>236/C8</td><td>39</td></tr> <tr><td>236/C8</td><td>40</td></tr> <tr><td>236/A2</td><td>41</td></tr> <tr><td>236/A2</td><td>42</td></tr> <tr><td>236/A3</td><td>43</td></tr> <tr><td>236/A3</td><td>44</td></tr> <tr><td>236/A4</td><td>45</td></tr> <tr><td>236/A4</td><td>46</td></tr> <tr><td>236/A5</td><td>47</td></tr> <tr><td>236/C2</td><td>48</td></tr> <tr><td>236/D4</td><td>49</td></tr> <tr><td>236/D5</td><td>50</td></tr> </table>	REFERENCE	2X51 CON & PROTIN CKTS.	236/A3	1	236/A6	2	236/A7	3	236/A8	4	236/C3	5	236/C4	6	236/C4	7	236/C4	8	236/C5	9	236/C5	10	236/C6	11	236/C6	12	236/C7	13	236/C7	14	236/C8	15	236/C8	16	237/A2	17	237/A2	18	237/A3	19	237/A4	20	237/A4	21	237/A5	22	237/C2	23	237/D4	24	237/D5	25	236/A3	26	236/A6	27	236/A7	28	236/A8	29	236/C3	30	236/C4	31	236/C4	32	236/C5	33	236/C5	34	236/C6	35	236/C6	36	236/C7	37	236/C7	38	236/C8	39	236/C8	40	236/A2	41	236/A2	42	236/A3	43	236/A3	44	236/A4	45	236/A4	46	236/A5	47	236/C2	48	236/D4	49	236/D5	50	<table> <tr><th>REFERENCE</th><th>2X51 CON &amp; PROTIN CKTS.</th></tr> <tr><td>239/B6</td><td>51</td></tr> <tr><td>239/F6</td><td>52</td></tr> <tr><td>239/B6</td><td>53</td></tr> <tr><td>239/F6</td><td>54</td></tr> <tr><td>240/E4</td><td>55</td></tr> <tr><td>240/E4</td><td>56</td></tr> <tr><td>240/E6</td><td>57</td></tr> <tr><td>240/E7</td><td>58</td></tr> <tr><td>SPARE</td><td>59</td></tr> <tr><td>SPARE</td><td>60</td></tr> <tr><td>SPARE</td><td>61</td></tr> <tr><td>SPARE</td><td>62</td></tr> <tr><td>SPARE</td><td>63</td></tr> <tr><td>SPARE</td><td>64</td></tr> <tr><td>SPARE</td><td>65</td></tr> <tr><td>SPARE</td><td>66</td></tr> <tr><td>SPARE</td><td>67</td></tr> <tr><td>SPARE</td><td>68</td></tr> <tr><td>SPARE</td><td>69</td></tr> <tr><td>SPARE</td><td>70</td></tr> <tr><td>SPARE</td><td>71</td></tr> <tr><td>SPARE</td><td>72</td></tr> <tr><td>SPARE</td><td>73</td></tr> <tr><td>SPARE</td><td>74</td></tr> <tr><td>SPARE</td><td>75</td></tr> </table>	REFERENCE	2X51 CON & PROTIN CKTS.	239/B6	51	239/F6	52	239/B6	53	239/F6	54	240/E4	55	240/E4	56	240/E6	57	240/E7	58	SPARE	59	SPARE	60	SPARE	61	SPARE	62	SPARE	63	SPARE	64	SPARE	65	SPARE	66	SPARE	67	SPARE	68	SPARE	69	SPARE	70	SPARE	71	SPARE	72	SPARE	73	SPARE	74	SPARE	75	<table> <tr><th>REFERENCE</th><th>XSH SPACE HEATER</th></tr> <tr><td>211/E5</td><td>1</td></tr> <tr><td>211/F6</td><td>2</td></tr> <tr><td>SPARE</td><td>3</td></tr> </table>	REFERENCE	XSH SPACE HEATER	211/E5	1	211/F6	2	SPARE	3	<table> <tr><th>REFERENCE</th><th>X6 ALM. CKT.</th></tr> <tr><td>212/C5</td><td>1</td></tr> <tr><td>212/C5</td><td>2</td></tr> <tr><td>292/E3</td><td>3</td></tr> <tr><td>SPARE</td><td>4</td></tr> <tr><td>SPARE</td><td>5</td></tr> </table>	REFERENCE	X6 ALM. CKT.	212/C5	1	212/C5	2	292/E3	3	SPARE	4	SPARE	5
REFERENCE	1X1 CT CKT.																																																																																																																																																																																																																																																																																																																																																																																																																																																							
221/B7	1																																																																																																																																																																																																																																																																																																																																																																																																																																																							
221/B7	2																																																																																																																																																																																																																																																																																																																																																																																																																																																							
221/C7	3																																																																																																																																																																																																																																																																																																																																																																																																																																																							
221/C7	4																																																																																																																																																																																																																																																																																																																																																																																																																																																							
221/C7	5																																																																																																																																																																																																																																																																																																																																																																																																																																																							
221/C7	6																																																																																																																																																																																																																																																																																																																																																																																																																																																							
221/C7	7																																																																																																																																																																																																																																																																																																																																																																																																																																																							
221/D7	8																																																																																																																																																																																																																																																																																																																																																																																																																																																							
221/D7	9																																																																																																																																																																																																																																																																																																																																																																																																																																																							
SPARE	10																																																																																																																																																																																																																																																																																																																																																																																																																																																							
222/B7	11																																																																																																																																																																																																																																																																																																																																																																																																																																																							
222/B7	12																																																																																																																																																																																																																																																																																																																																																																																																																																																							
222/C7	13																																																																																																																																																																																																																																																																																																																																																																																																																																																							
222/C7	14																																																																																																																																																																																																																																																																																																																																																																																																																																																							
222/C7	15																																																																																																																																																																																																																																																																																																																																																																																																																																																							
222/C7	16																																																																																																																																																																																																																																																																																																																																																																																																																																																							
222/C7	17																																																																																																																																																																																																																																																																																																																																																																																																																																																							
222/D7	18																																																																																																																																																																																																																																																																																																																																																																																																																																																							
222/D7	19																																																																																																																																																																																																																																																																																																																																																																																																																																																							
SPARE	20																																																																																																																																																																																																																																																																																																																																																																																																																																																							
SPARE	21																																																																																																																																																																																																																																																																																																																																																																																																																																																							
SPARE	22																																																																																																																																																																																																																																																																																																																																																																																																																																																							
SPARE	23																																																																																																																																																																																																																																																																																																																																																																																																																																																							
SPARE	24																																																																																																																																																																																																																																																																																																																																																																																																																																																							
SPARE	25																																																																																																																																																																																																																																																																																																																																																																																																																																																							
REFERENCE	2X1 CT CKT.																																																																																																																																																																																																																																																																																																																																																																																																																																																							
223/B7	1																																																																																																																																																																																																																																																																																																																																																																																																																																																							
223/B7	2																																																																																																																																																																																																																																																																																																																																																																																																																																																							
223/C7	3																																																																																																																																																																																																																																																																																																																																																																																																																																																							
223/C7	4																																																																																																																																																																																																																																																																																																																																																																																																																																																							
223/C7	5																																																																																																																																																																																																																																																																																																																																																																																																																																																							
223/C7	6																																																																																																																																																																																																																																																																																																																																																																																																																																																							
223/C7	7																																																																																																																																																																																																																																																																																																																																																																																																																																																							
223/D7	8																																																																																																																																																																																																																																																																																																																																																																																																																																																							
223/D7	9																																																																																																																																																																																																																																																																																																																																																																																																																																																							
SPARE	10																																																																																																																																																																																																																																																																																																																																																																																																																																																							
224/B7	11																																																																																																																																																																																																																																																																																																																																																																																																																																																							
224/B7	12																																																																																																																																																																																																																																																																																																																																																																																																																																																							
224/C7	13																																																																																																																																																																																																																																																																																																																																																																																																																																																							
224/C7	14																																																																																																																																																																																																																																																																																																																																																																																																																																																							
224/C7	15																																																																																																																																																																																																																																																																																																																																																																																																																																																							
224/C7	16																																																																																																																																																																																																																																																																																																																																																																																																																																																							
224/C7	17																																																																																																																																																																																																																																																																																																																																																																																																																																																							
224/D7	18																																																																																																																																																																																																																																																																																																																																																																																																																																																							
224/D7	19																																																																																																																																																																																																																																																																																																																																																																																																																																																							
SPARE	20																																																																																																																																																																																																																																																																																																																																																																																																																																																							
SPARE	21																																																																																																																																																																																																																																																																																																																																																																																																																																																							
SPARE	22																																																																																																																																																																																																																																																																																																																																																																																																																																																							
SPARE	23																																																																																																																																																																																																																																																																																																																																																																																																																																																							
SPARE	24																																																																																																																																																																																																																																																																																																																																																																																																																																																							
SPARE	25																																																																																																																																																																																																																																																																																																																																																																																																																																																							
REFERENCE	1X51 CON & PROTIN CKTS.																																																																																																																																																																																																																																																																																																																																																																																																																																																							
231/A3	1																																																																																																																																																																																																																																																																																																																																																																																																																																																							
231/A6	2																																																																																																																																																																																																																																																																																																																																																																																																																																																							
231/A7	3																																																																																																																																																																																																																																																																																																																																																																																																																																																							
231/A6	4																																																																																																																																																																																																																																																																																																																																																																																																																																																							
231/C3	5																																																																																																																																																																																																																																																																																																																																																																																																																																																							
231/C4	6																																																																																																																																																																																																																																																																																																																																																																																																																																																							
231/C4	7																																																																																																																																																																																																																																																																																																																																																																																																																																																							
231/C4	8																																																																																																																																																																																																																																																																																																																																																																																																																																																							
231/C5	9																																																																																																																																																																																																																																																																																																																																																																																																																																																							
231/C5	10																																																																																																																																																																																																																																																																																																																																																																																																																																																							
231/C6	11																																																																																																																																																																																																																																																																																																																																																																																																																																																							
231/C6	12																																																																																																																																																																																																																																																																																																																																																																																																																																																							
231/C7	13																																																																																																																																																																																																																																																																																																																																																																																																																																																							
231/C7	14																																																																																																																																																																																																																																																																																																																																																																																																																																																							
231/C8	15																																																																																																																																																																																																																																																																																																																																																																																																																																																							
231/C8	16																																																																																																																																																																																																																																																																																																																																																																																																																																																							
232/A2	17																																																																																																																																																																																																																																																																																																																																																																																																																																																							
232/A2	18																																																																																																																																																																																																																																																																																																																																																																																																																																																							
232/A3	19																																																																																																																																																																																																																																																																																																																																																																																																																																																							
232/A4	20																																																																																																																																																																																																																																																																																																																																																																																																																																																							
232/A4	21																																																																																																																																																																																																																																																																																																																																																																																																																																																							
232/A5	22																																																																																																																																																																																																																																																																																																																																																																																																																																																							
232/C2	23																																																																																																																																																																																																																																																																																																																																																																																																																																																							
232/D4	24																																																																																																																																																																																																																																																																																																																																																																																																																																																							
232/D5	25																																																																																																																																																																																																																																																																																																																																																																																																																																																							
233/A3	26																																																																																																																																																																																																																																																																																																																																																																																																																																																							
233/A6	27																																																																																																																																																																																																																																																																																																																																																																																																																																																							
233/A7	28																																																																																																																																																																																																																																																																																																																																																																																																																																																							
233/A6	29																																																																																																																																																																																																																																																																																																																																																																																																																																																							
233/C3	30																																																																																																																																																																																																																																																																																																																																																																																																																																																							
233/C4	31																																																																																																																																																																																																																																																																																																																																																																																																																																																							
233/C4	32																																																																																																																																																																																																																																																																																																																																																																																																																																																							
233/C4	33																																																																																																																																																																																																																																																																																																																																																																																																																																																							
233/C5	34																																																																																																																																																																																																																																																																																																																																																																																																																																																							
233/C5	35																																																																																																																																																																																																																																																																																																																																																																																																																																																							
233/C6	36																																																																																																																																																																																																																																																																																																																																																																																																																																																							
233/C6	37																																																																																																																																																																																																																																																																																																																																																																																																																																																							
233/C7	38																																																																																																																																																																																																																																																																																																																																																																																																																																																							
233/C7	39																																																																																																																																																																																																																																																																																																																																																																																																																																																							
233/C8	40																																																																																																																																																																																																																																																																																																																																																																																																																																																							
233/C8	41																																																																																																																																																																																																																																																																																																																																																																																																																																																							
234/A2	42																																																																																																																																																																																																																																																																																																																																																																																																																																																							
234/A2	43																																																																																																																																																																																																																																																																																																																																																																																																																																																							
234/A3	44																																																																																																																																																																																																																																																																																																																																																																																																																																																							
234/A4	45																																																																																																																																																																																																																																																																																																																																																																																																																																																							
234/A4	46																																																																																																																																																																																																																																																																																																																																																																																																																																																							
234/A5	47																																																																																																																																																																																																																																																																																																																																																																																																																																																							
234/C2	48																																																																																																																																																																																																																																																																																																																																																																																																																																																							
234/D4	49																																																																																																																																																																																																																																																																																																																																																																																																																																																							
234/D5	50																																																																																																																																																																																																																																																																																																																																																																																																																																																							
REFERENCE	1X51 CON & PROTIN CKTS.																																																																																																																																																																																																																																																																																																																																																																																																																																																							
234/B6	51																																																																																																																																																																																																																																																																																																																																																																																																																																																							
234/F6	52																																																																																																																																																																																																																																																																																																																																																																																																																																																							
234/B6	53																																																																																																																																																																																																																																																																																																																																																																																																																																																							
234/F6	54																																																																																																																																																																																																																																																																																																																																																																																																																																																							
235/E4	55																																																																																																																																																																																																																																																																																																																																																																																																																																																							
235/E4	56																																																																																																																																																																																																																																																																																																																																																																																																																																																							
235/E6	57																																																																																																																																																																																																																																																																																																																																																																																																																																																							
235/E7	58																																																																																																																																																																																																																																																																																																																																																																																																																																																							
SPARE	59																																																																																																																																																																																																																																																																																																																																																																																																																																																							
SPARE	60																																																																																																																																																																																																																																																																																																																																																																																																																																																							
SPARE	61																																																																																																																																																																																																																																																																																																																																																																																																																																																							
SPARE	62																																																																																																																																																																																																																																																																																																																																																																																																																																																							
SPARE	63																																																																																																																																																																																																																																																																																																																																																																																																																																																							
SPARE	64																																																																																																																																																																																																																																																																																																																																																																																																																																																							
SPARE	65																																																																																																																																																																																																																																																																																																																																																																																																																																																							
SPARE	66																																																																																																																																																																																																																																																																																																																																																																																																																																																							
SPARE	67																																																																																																																																																																																																																																																																																																																																																																																																																																																							
SPARE	68																																																																																																																																																																																																																																																																																																																																																																																																																																																							
SPARE	69																																																																																																																																																																																																																																																																																																																																																																																																																																																							
SPARE	70																																																																																																																																																																																																																																																																																																																																																																																																																																																							
SPARE	71																																																																																																																																																																																																																																																																																																																																																																																																																																																							
SPARE	72																																																																																																																																																																																																																																																																																																																																																																																																																																																							
SPARE	73																																																																																																																																																																																																																																																																																																																																																																																																																																																							
SPARE	74																																																																																																																																																																																																																																																																																																																																																																																																																																																							
SPARE	75																																																																																																																																																																																																																																																																																																																																																																																																																																																							
REFERENCE	2X51 CON & PROTIN CKTS.																																																																																																																																																																																																																																																																																																																																																																																																																																																							
236/A3	1																																																																																																																																																																																																																																																																																																																																																																																																																																																							
236/A6	2																																																																																																																																																																																																																																																																																																																																																																																																																																																							
236/A7	3																																																																																																																																																																																																																																																																																																																																																																																																																																																							
236/A8	4																																																																																																																																																																																																																																																																																																																																																																																																																																																							
236/C3	5																																																																																																																																																																																																																																																																																																																																																																																																																																																							
236/C4	6																																																																																																																																																																																																																																																																																																																																																																																																																																																							
236/C4	7																																																																																																																																																																																																																																																																																																																																																																																																																																																							
236/C4	8																																																																																																																																																																																																																																																																																																																																																																																																																																																							
236/C5	9																																																																																																																																																																																																																																																																																																																																																																																																																																																							
236/C5	10																																																																																																																																																																																																																																																																																																																																																																																																																																																							
236/C6	11																																																																																																																																																																																																																																																																																																																																																																																																																																																							
236/C6	12																																																																																																																																																																																																																																																																																																																																																																																																																																																							
236/C7	13																																																																																																																																																																																																																																																																																																																																																																																																																																																							
236/C7	14																																																																																																																																																																																																																																																																																																																																																																																																																																																							
236/C8	15																																																																																																																																																																																																																																																																																																																																																																																																																																																							
236/C8	16																																																																																																																																																																																																																																																																																																																																																																																																																																																							
237/A2	17																																																																																																																																																																																																																																																																																																																																																																																																																																																							
237/A2	18																																																																																																																																																																																																																																																																																																																																																																																																																																																							
237/A3	19																																																																																																																																																																																																																																																																																																																																																																																																																																																							
237/A4	20																																																																																																																																																																																																																																																																																																																																																																																																																																																							
237/A4	21																																																																																																																																																																																																																																																																																																																																																																																																																																																							
237/A5	22																																																																																																																																																																																																																																																																																																																																																																																																																																																							
237/C2	23																																																																																																																																																																																																																																																																																																																																																																																																																																																							
237/D4	24																																																																																																																																																																																																																																																																																																																																																																																																																																																							
237/D5	25																																																																																																																																																																																																																																																																																																																																																																																																																																																							
236/A3	26																																																																																																																																																																																																																																																																																																																																																																																																																																																							
236/A6	27																																																																																																																																																																																																																																																																																																																																																																																																																																																							
236/A7	28																																																																																																																																																																																																																																																																																																																																																																																																																																																							
236/A8	29																																																																																																																																																																																																																																																																																																																																																																																																																																																							
236/C3	30																																																																																																																																																																																																																																																																																																																																																																																																																																																							
236/C4	31																																																																																																																																																																																																																																																																																																																																																																																																																																																							
236/C4	32																																																																																																																																																																																																																																																																																																																																																																																																																																																							
236/C5	33																																																																																																																																																																																																																																																																																																																																																																																																																																																							
236/C5	34																																																																																																																																																																																																																																																																																																																																																																																																																																																							
236/C6	35																																																																																																																																																																																																																																																																																																																																																																																																																																																							
236/C6	36																																																																																																																																																																																																																																																																																																																																																																																																																																																							
236/C7	37																																																																																																																																																																																																																																																																																																																																																																																																																																																							
236/C7	38																																																																																																																																																																																																																																																																																																																																																																																																																																																							
236/C8	39																																																																																																																																																																																																																																																																																																																																																																																																																																																							
236/C8	40																																																																																																																																																																																																																																																																																																																																																																																																																																																							
236/A2	41																																																																																																																																																																																																																																																																																																																																																																																																																																																							
236/A2	42																																																																																																																																																																																																																																																																																																																																																																																																																																																							
236/A3	43																																																																																																																																																																																																																																																																																																																																																																																																																																																							
236/A3	44																																																																																																																																																																																																																																																																																																																																																																																																																																																							
236/A4	45																																																																																																																																																																																																																																																																																																																																																																																																																																																							
236/A4	46																																																																																																																																																																																																																																																																																																																																																																																																																																																							
236/A5	47																																																																																																																																																																																																																																																																																																																																																																																																																																																							
236/C2	48																																																																																																																																																																																																																																																																																																																																																																																																																																																							
236/D4	49																																																																																																																																																																																																																																																																																																																																																																																																																																																							
236/D5	50																																																																																																																																																																																																																																																																																																																																																																																																																																																							
REFERENCE	2X51 CON & PROTIN CKTS.																																																																																																																																																																																																																																																																																																																																																																																																																																																							
239/B6	51																																																																																																																																																																																																																																																																																																																																																																																																																																																							
239/F6	52																																																																																																																																																																																																																																																																																																																																																																																																																																																							
239/B6	53																																																																																																																																																																																																																																																																																																																																																																																																																																																							
239/F6	54																																																																																																																																																																																																																																																																																																																																																																																																																																																							
240/E4	55																																																																																																																																																																																																																																																																																																																																																																																																																																																							
240/E4	56																																																																																																																																																																																																																																																																																																																																																																																																																																																							
240/E6	57																																																																																																																																																																																																																																																																																																																																																																																																																																																							
240/E7	58																																																																																																																																																																																																																																																																																																																																																																																																																																																							
SPARE	59																																																																																																																																																																																																																																																																																																																																																																																																																																																							
SPARE	60																																																																																																																																																																																																																																																																																																																																																																																																																																																							
SPARE	61																																																																																																																																																																																																																																																																																																																																																																																																																																																							
SPARE	62																																																																																																																																																																																																																																																																																																																																																																																																																																																							
SPARE	63																																																																																																																																																																																																																																																																																																																																																																																																																																																							
SPARE	64																																																																																																																																																																																																																																																																																																																																																																																																																																																							
SPARE	65																																																																																																																																																																																																																																																																																																																																																																																																																																																							
SPARE	66																																																																																																																																																																																																																																																																																																																																																																																																																																																							
SPARE	67																																																																																																																																																																																																																																																																																																																																																																																																																																																							
SPARE	68																																																																																																																																																																																																																																																																																																																																																																																																																																																							
SPARE	69																																																																																																																																																																																																																																																																																																																																																																																																																																																							
SPARE	70																																																																																																																																																																																																																																																																																																																																																																																																																																																							
SPARE	71																																																																																																																																																																																																																																																																																																																																																																																																																																																							
SPARE	72																																																																																																																																																																																																																																																																																																																																																																																																																																																							
SPARE	73																																																																																																																																																																																																																																																																																																																																																																																																																																																							
SPARE	74																																																																																																																																																																																																																																																																																																																																																																																																																																																							
SPARE	75																																																																																																																																																																																																																																																																																																																																																																																																																																																							
REFERENCE	XSH SPACE HEATER																																																																																																																																																																																																																																																																																																																																																																																																																																																							
211/E5	1																																																																																																																																																																																																																																																																																																																																																																																																																																																							
211/F6	2																																																																																																																																																																																																																																																																																																																																																																																																																																																							
SPARE	3																																																																																																																																																																																																																																																																																																																																																																																																																																																							
REFERENCE	X6 ALM. CKT.																																																																																																																																																																																																																																																																																																																																																																																																																																																							
212/C5	1																																																																																																																																																																																																																																																																																																																																																																																																																																																							
212/C5	2																																																																																																																																																																																																																																																																																																																																																																																																																																																							
292/E3	3																																																																																																																																																																																																																																																																																																																																																																																																																																																							
SPARE	4																																																																																																																																																																																																																																																																																																																																																																																																																																																							
SPARE	5																																																																																																																																																																																																																																																																																																																																																																																																																																																							
B																																																																																																																																																																																																																																																																																																																																																																																																																																																								
C																																																																																																																																																																																																																																																																																																																																																																																																																																																								
D																																																																																																																																																																																																																																																																																																																																																																																																																																																								
E																																																																																																																																																																																																																																																																																																																																																																																																																																																								
F																																																																																																																																																																																																																																																																																																																																																																																																																																																								

AS-BUILT BY _____ DATE _____		CONTRACT NO. 11131113/00		JOB ORDER NO. S-13656		TERMINAL BLOCKS PANEL +BB1-4		الشركة الوطنية لنقل الكهرباء		نقل الكهرباء	
01 13 49		FACTORY ASBUILT		DRAWN BY RIZ CHECKED BY KVR		132KV BUSBAR PROTIN MAIN-1 BU PANEL +BBP1-4		National Grid sa		REV. NO.	
00 13 05		FOR APPROVAL		DATE STARTED 28.01.2013 DATE COMPLETED _____		S/S 8709 - 132/13.8KV IN AL-KHARJ CITY		INDEX PLANT NO. C421		DRAWING NUMBER CD-322997	
REV. NO.		DATE		DESCRIPTION		PRG. DEPT. CTPD ENG. DEPT. AUT-PSAC		SAUDI ARABIA		SHEET NO. 301	
										CONT. NIL	